


1 LOCATION OF WATER WELL: County: Wilson Fraction: SE 1/4 SW 1/4 NW 1/4 Section Number: 24 Township Number: T 29 S Range Number: R 14 E

Distance and direction from nearest town or city street address of well if located within city? 1 1/2 m S Fredonia, ks

2 WATER WELL OWNER: Fredonia Golf Club  
 RR#, St. Address, Box #: Rt 3  
 City, State, ZIP Code: Fredonia, ks 66736  
 Board of Agriculture, Division of Water Resources  
 Application Number:

3 LOCATE WELL'S LOCATION WITH AN "X" IN SECTION BOX:

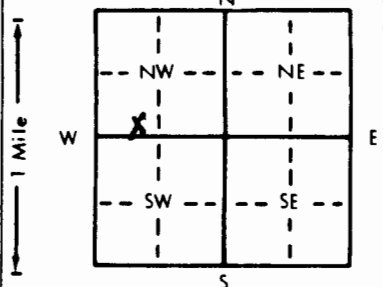

4 DEPTH OF COMPLETED WELL: 830 ft. ELEVATION: 0-5-94  
 Depth(s) Groundwater Encountered 1. 35 ft. 2. ft. 3. ft.  
 WELL'S STATIC WATER LEVEL 25 ft. below land surface measured on mo/day/yr

Pump test data: Well water was ft. after NA hours pumping gpm  
 Est. Yield gpm: Well water was ft. after hours pumping gpm  
 Bore Hole Diameter: 11 in. to 25 ft., and 8 in. to 80 ft.

WELL WATER TO BE USED AS:  
 1 Domestic 3 Feedlot 6 Oil field water supply 9 Dewatering 12 Other (Specify below)  
 2 Irrigation 4 Industrial 7 Lawn and garden only 10 Monitoring well

Was a chemical/bacteriological sample submitted to Department? Yes No If yes, mo/day/yr sample was submitted  
 Water Well Disinfected? Yes yes No

5 TYPE OF BLANK CASING USED:  
 1 Steel 3 RMP (SR) 5 Wrought iron 8 Concrete tile CASING JOINTS: Glued Clamped  
 2 PVC 4 ABS 6 Asbestos-Cement 9 Other (specify below) Welded  
 7 Fiberglass Threaded

Blank casing diameter 6 in. to ft., Dia. in. to ft., Dia. in. to ft.  
 Casing height above land surface 30 in., weight lbs./ft. Wall thickness or gauge No. 160

TYPE OF SCREEN OR PERFORATION MATERIAL:  
 1 Steel 3 Stainless steel 5 Fiberglass 8 RMP (SR) 10 Asbestos-cement  
 2 Brass 4 Galvanized steel 6 Concrete tile 9 ABS 11 Other (specify)  
 12 None used (open hole)

SCREEN OR PERFORATION OPENINGS ARE:  
 1 Continuous slot 3 Mill slot 5 Gauzed wrapped 8 Saw cut 11 None (open hole)  
 2 Louvered shutter 4 Key punched 6 Wire wrapped 9 Drilled holes  
 7 Torch cut 10 Other (specify)

SCREEN-PERFORATED INTERVALS: From 70 ft. to 30 ft., From ft. to ft.  
 From ft. to ft., From ft. to ft.

GRAVEL PACK INTERVALS: From 80 ft. to 25 ft., From ft. to ft.  
 From ft. to ft., From ft. to ft.

6 GROUT MATERIAL: 1 Neat cement 2 Cement grout 3 Bentonite 4 Other  
 Grout intervals: From 25 ft. to 2 ft., From ft. to ft., From ft. to ft.

What is the nearest source of possible contamination:  
 1 Septic tank 4 Lateral lines 7 Pit privy 10 Livestock pens 14 Abandoned water well  
 2 Sewer lines 5 Cess pool 8 Sewage lagoon 11 Fuel storage 15 Oil well/Gas well  
 3 Watertight sewer lines 6 Seepage pit 9 Feedyard 12 Fertilizer storage 16 Other (specify below)  
 13 Insecticide storage

Direction from well? How many feet? River 100

FROM	TO	LITHOLOGIC LOG	FROM	TO	PLUGGING INTERVALS
0	3	Soil			
3	10	Shale dark			
10	20	Clay			
20	30	Red shale shale			
30	35	Yellow clay			
35	43	Gravel			
43	48	lime			
48	80	Shale w/ thin str			

7 CONTRACTOR'S OR LANDOWNER'S CERTIFICATION: This water well was (1) constructed, (2) reconstructed, or (3) plugged under my jurisdiction and was completed on (mo/day/year) 8-6-94 and this record is true to the best of my knowledge and belief. Kansas Water Well Contractor's License No. 5124 This Water Well Record was completed on (mo/day/yr) 8-3-94 under the business name of Jeffrey Well Drilling by (signature) Jack B. Jeffrey