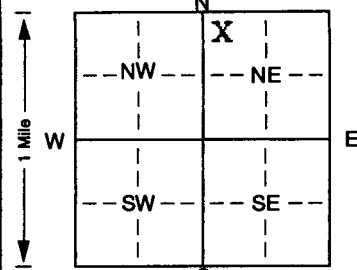


MW5

1] LOCATION OF WATER WELL: Fraction SW 1/4 SW 1/4 SE 1/4 Section Number 9 Township Number T 29 S Range Number R 16 E/W
 County: Wilson

Distance and direction from nearest town or city street address of well if located within city?
13th & Quincy Altoona, Kansas

2] WATER WELL OWNER: John Hrenak
 RR#, St. Address, Box #: P.O. Box 498 Chanute KS 66720 Board of Agriculture, Division of Water Resources
 City, State, ZIP Code: Application Number:

3] LOCATE WELL'S LOCATION WITH AN "X" IN SECTION BOX:

 4] DEPTH OF COMPLETED WELL: 15 ft. ELEVATION: 830.72
 Depth(s) Groundwater Encountered 8.90 ~ 9 ft. 2. ft. 3. ft.
 WELL'S STATIC WATER LEVEL 8.90 ft. below land surface measured on mo/day/yr 07/30/02
 Pump test data: Well water was _____ ft. after _____ hours pumping _____ gpm
 Est. Yield _____ gpm; Well water was _____ ft. after _____ hours pumping _____ gpm
 Bore Hole Diameter: 8.25 in. to 15 in. to _____ in. to _____ ft.
 WELL WATER TO BE USED AS: 5 Public water supply 8 Air conditioning 11 Injection well
 1 Domestic 3 Feedlot 6 Oil field water supply 9 Dewatering 12 Other (Specify below)
 2 Irrigation 4 Industrial 7 Domestic (lawn & garden) 10 Monitoring well
 Was a chemical/bacteriological sample submitted to Department? Yes. _____ No. X; If yes, mo/day/yrs sample was submitted
 Water Well Disinfected? Yes _____ No X

5] TYPE OF BLANK CASING USED:
 1 Steel 3 RMP (SR) 5 Wrought iron 8 Concrete tile CASING JOINTS: Glued. _____ Clamped. _____
2 PVC 4 ABS 1.0 2.06 7 Fiberglass _____ Welded _____
 Blank casing diameter _____ in. to _____ ft., Dia _____ in. to _____ ft., Dia _____ in. to _____ ft.
 Casing height above land surface _____ in., weight 0.8 lbs./ft. Wall thickness or gauge No. SCH 40
 TYPE OF SCREEN OR PERFORATION MATERIAL:
 1 Steel 3 Stainless steel 5 Fiberglass 8 RMP (SR) 10 Asbestos-cement
 2 Brass 4 Galvanized steel 6 Concrete tile 9 ABS 11 Other (specify) _____
 12 None used (open hole)
 SCREEN OR PERFORATION OPENINGS ARE:
 1 Continuous slot 3 Mill slot 5 Gauzed wrapped 8 Saw cut 11 None (open hole)
 2 Louvered shutter 4 Key punched 6 Wire wrapped 9 Drilled holes
 7 Torch cut 10 Other (specify) _____ ft.
 SCREEN-PERFORATED INTERVALS: From _____ 5 ft. to _____ 15 ft., From _____ ft. to _____ ft.
 From _____ 3 ft. to _____ 15 ft., From _____ ft. to _____ ft.
 GRAVEL PACK INTERVALS: From _____ ft. to _____ ft., From _____ ft. to _____ ft.
 From _____ ft. to _____ ft., From _____ ft. to _____ ft.

6] GROUT MATERIAL: 1 Neat cement 3 2 Cement grout 3 Bentonite 4 Other _____
 Grout intervals: From _____ ft. to _____ ft., From _____ ft. to _____ ft., From _____ ft. to _____ ft.
 What is the nearest source of possible contamination:
 1 Septic tank 4 Lateral lines 7 Pit privy 10 Livestock pens 14 Abandoned water well
 2 Sewer lines 5 Cess pool 8 Sewage lagoon 11 Fuel storage 15 Oil well/Gas well
 3 Watertight sewer lines 6 Seepage pit 9 Feedyard 12 Fertilizer storage 16 Other (specify below)
13 Insecticide storage Lust Site
 Direction from well? How many feet?

FROM	TO	LITHOLOGIC LOG	FROM	TO	PLUGGING INTERVALS
0'	0.5'	Crushed Rock.			
0.5'	15'	Clay, brown, silty, dry, dense, high plasticity. /CH			

7] CONTRACTOR'S OR LANDOWNER'S CERTIFICATION: This water well was (1) constructed, (2) reconstructed, or (3) plugged under my jurisdiction and was completed on (mo/day/year) 07/30/02 and this record is true to the best of my knowledge and belief. Kansas
 Water Well Contractor's Licence No. 594 This Water Well Record was completed on (mo/day/yr) 08/13/02
 under the business name of Coranco Great Plains Inc. by (signature) John Hrenak