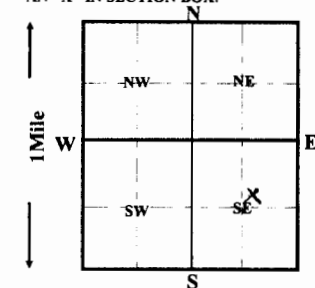


1 LOCATION OF WATER WELL: Sedgwick		FRACTION SW 1/4 NE 1/4 SE 1/4		Section Number 32	Township Number T 29 S	Range Number R 2E E/W
Distance and direction from nearest town or city street address of well if located within city? 602 Trail Dr. Mulvane, Kansas						
WATER WELL OWNER: WILSON, Gary RR#, ST. ADDRESS, BOX #: 602 Trail Dr. CITY, STATE, ZIP CODE: Mulvane, Kansas		Board of Agriculture, Division of Water Resource Application Number:				
3 LOCATE WELL'S LOCATION WITH AN "X" IN SECTION BOX: 		4 DEPTH OF COMPLETED WELL 80 ft. ELEVATION: Depth(s) groundwater Encountered 1 ft. 2 ft. 3 ft. WELL'S STATIC WATER LEVEL 40 FT. BELOW LAND SURFACE MEASURED ON mo/day/yr 7-24-2001 Pump test data: Well water was ft. after hours pumping gpm Est. Yield gpm Well water was ft. after hours pumping gpm Bore Hole Diameter 12 in. to 80 ft. and in. to ft. WELL WATER TO BE USED AS: 5 Public water supply 8 Air conditioning 11 Injection well 1 Domestic 3 Feedlot 6 Oil field water supply 9 Dewatering 12 Other (Specify below) 2 Irrigation 4 Industrial 7 Lawn and garden only 10 Monitoring well Was a chemical/bacteriological sample submitted to Department? Yes No X ; If yes, mo/day/yr sample was submitted Water Well Disinfected? Yes X No				
5 TYPE OF CASING USED: 1 Steel 3 RMP (SR) 2 PVC 4 ABS Blank casing Diameter 5 in. to 40 ft., Dia in. to ft. Casing height above land surface 12 in., weight 2.35 lbs. / ft. Wall thickness or gauge No. .214 TYPE OF SCREEN OR PERFORATION MATERIAL: 1 Steel 3 Stainless Steel 5 Fiberglass 8 RMP (SR) 2 Brass 4 Galvanized steel 6 Concrete tile 9 ABS SCREEN OR PERFORATION OPENING ARE: 1 Continuous slot 3 Mill slot 5 Gauzed wrapped 8 Saw cut 11 None (open hole) 2 Louvered shutter 4 Key punched 6 Wire wrapped 9 Drilled holes 7 Torch cut 10 Other (specify) SCREEN-PERFORATION INTERVALS: from 40 ft. to 80 ft., From ft. to ft. GRAVEL PACK INTERVALS: from 24 ft. to 80 ft., From ft. to ft. from ft. to ft., From ft. to ft.		CASING JOINTS: Glued X Clamped Welded Threaded SDR-26				
6 GROUT MATERIAL: 1 Neat cement 2 Cement grout 3 Bentonite 4 Other bentonite hole plug Grout Intervals: From ft. to ft. From ft. to ft. From 4 ft. to 24 ft. What is the nearest source of possible contamination: 1 Septic tank 4 Lateral lines 7 Pit privy 10 Livestock pens 14 Abandon water well 2 Sewer lines 5 Cess pool 8 Sewage lagoon 11 Fuel storage 15 Oil well/Gas well 3 Watertight sewer lines 6 Seepage pit 9 Feedyard 12 Fertilizer storage 16 Other (specify below) 13 Insecticide storage Direction from well? West How many feet? 75						
FROM TO LITHOLOGIC LOG		FROM TO PLUGGING INTERVALS				
0	3	topsoil				
3	31	clay				
31	39	fine sand				
39	45	medium sand				
45	80	grey shale				
7 CONTRACTOR'S OR LANDOWNER'S CERTIFICATION: This water well was (1) <u>constructed</u> , (2) reconstructed, or (3) plugged under my jurisdiction and was completed on (mo/day/year) <u>7-24-2001</u> and this record is true to the best of my knowledge and belief. Kansas Water Well Contractor's License No. <u>236</u> This Water Well Record was completed on (mo/day/yr) <u>7-27-2001</u> Under the business name of <u>Harp Well & Pump Service, Inc</u> by (signature) <u>Todd S. Harp</u>						