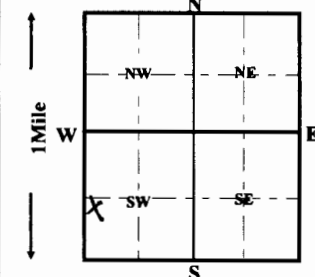


1 LOCATION OF WATER WELL:		FRACTION		Section Number		Township Number		Range Number	
Sedgwick		NW 1/4 SW 1/4 SW 1/4		29		T 29 S		R 2E E/W	
Distance and direction from nearest town or city street address of well if located within city?									
109 Maplewood Mulvane, Kansas									
WATER WELL OWNER: MILLSAP, Pat									
RR#, ST. ADDRESS, BOX #: 109 Maplewood									
CITY, STATE, ZIP CODE: Mulvane, Kansas									
Board of Agriculture, Division of Water Resource									
Application Number:									
LOCATE WELL'S LOCATION WITH AN "X" IN SECTION BOX:									
									
4 DEPTH OF COMPLETED WELL 98 ft. ELEVATION:									
Depth(s) groundwater Encountered 1 ft. 2 ft. 3 ft.									
WELL'S STATIC WATER LEVEL 45 FT. BELOW LAND SURFACE MEASURED ON mo/day/yr 8-15-2001									
Pump test data: Well water was ft. after hours pumping gpm									
Est. Yield gpm: Well water was ft. after hours pumping gpm									
Bore Hole Diameter 12 in. to 98 ft. and in. to ft.									
WELL WATER TO BE USED AS: 5 Public water supply 8 Air conditioning 11 Injection well									
1 Domestic 3 Feedlot 6 Oil field water supply 9 Dewatering 12 Other (Specify below)									
2 Irrigation 4 Industrial 7 Lawn and garden only 10 Monitoring well									
Was a chemical/bacteriological sample submitted to Department? Yes No X ; If yes, mo/day/yr sample was submitted									
Water Well Disinfected? Yes X No									
5 TYPE OF CASING USED:									
1 Steel 3 RMP (SR) 5 Wrought iron 8 Concrete tile CASING JOINTS: Glued X Clamped									
2 PVC 4 ABS 6 Asbestos-Cement 9 Other (Specify below) Welded									
7 Fiberglass SDR-26 Threaded									
Blank casing Diameter 5 in. to 58 ft., Dia in. to ft., Dia in. to ft.									
Casing height above land surface 12 in., weight 2.35 lbs./ft. Wall thickness or gauge No. .214									
TYPE OF SCREEN OR PERFORATION MATERIAL:									
1 Steel 3 Stainless Steel 5 Fiberglass 8 RMP (SR) 11 other (specify)									
2 Brass 4 Galvanized steel 6 Concrete tile 9 ABS 12 None used (open hole)									
SCREEN OR PERFORATION OPENING ARE:									
1 Continuous slot 3 Mill slot 5 Gauzed wrapped 8 Saw cut 11 None (open hole)									
2 Louvered shutter 4 Key punched 6 Wire wrapped 9 Drilled holes									
7 Torch cut 10 Other (specify)									
SCREEN-PERFORATION INTERVALS: from 58 ft. to 98 ft., From ft. to ft.									
GRAVEL PACK INTERVALS: from 24 ft. to 98 ft., From ft. to ft.									
6 GROUT MATERIAL: 1 Neat cement 2 Cement grout 3 Bentonite 4 Other bentonite hole plug									
Grout Intervals: From ft. to ft. From ft. to ft. From 4 ft. to 24 ft.									
What is the nearest source of possible contamination:									
1 Septic tank 4 Lateral lines 7 Pit privy 10 Livestock pens 14 Abandon water well									
2 Sewer lines 5 Cess pool 8 Sewage lagoon 11 Fuel storage 15 Oil well/Gas well									
3 Watertight sewer lines 6 Seepage pit 9 Feedyard 12 Fertilizer storage 16 Other (specify below)									
13 Insecticide storage									
Direction from well? East How many feet? 12									
FROM TO LITHOLOGIC LOG FROM TO PLUGGING INTERVALS									
0 3 topsoil									
3 45 clay									
45 62 fine sand									
62 75 grey shale									
75 79 fine sand									
79 98 grey shale									
7 CONTRACTOR'S OR LANDOWNER'S CERTIFICATION: This water well was (1) constructed, (2) reconstructed, or (3) plugged under my jurisdiction and was completed on (mo/day/year) 8-15-2001 and this record is true to the best of my knowledge and belief. Kansas Water Well Contractor's License No. 236 This Water Well Record was completed on (mo/day/yr) 8-17-2001									
Under the business name of Harp Well & Pump Service, Inc by (signature) Todd S. Harp									