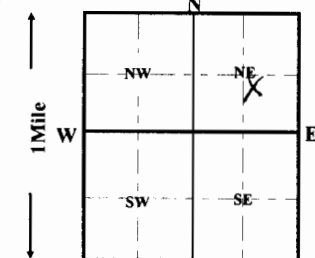


|   |  |   |  |                             |                                  |                                 |
|---|--|---|--|-----------------------------|----------------------------------|---------------------------------|
| 1 LOCATION OF WATER WELL:<br><b>Sedgwick</b>   |  | FRACTION<br><b>NW 1/4 SE 1/4 NE 1/4</b>   |  | Section Number<br><b>32</b> | Township Number<br><b>T 29 S</b> | Range Number<br><b>R 2E E/W</b> |
| Distance and direction from nearest town or city street address of well if located within city?<br><b>904 Saddle Run Mulvane, Kansas</b>   |  |   |  |                             |                                  |                                 |
| WATER WELL OWNER: <b>WILSON, Mary Lou</b><br>RR#, ST. ADDRESS, BOX #: <b>904 Saddle Run</b><br>CITY, STATE, ZIP CODE: <b>Mulvane, Kansas</b><br>Board of Agriculture, Division of Water Resource<br>Application Number:   |  |   |  |                             |                                  |                                 |
| LOCATE WELL'S LOCATION WITH AN "X" IN SECTION BOX:<br>   |  | 4 DEPTH OF COMPLETED WELL <b>79</b> ft. ELEVATION:<br>Depth(s) groundwater Encountered <b>1</b> ft. <b>2</b> ft. <b>3</b> ft.<br>WELL'S STATIC WATER LEVEL <b>45</b> FT. BELOW LAND SURFACE MEASURED ON <b>mo/day/yr 2-18-2002</b><br>Pump test data: Well water was <b>ft. after</b> hours pumping <b>gpm</b><br>Est. Yield <b>gpm</b> Well water was <b>ft. after</b> hours pumping <b>gpm</b><br>Bore Hole Diameter <b>12</b> in. to <b>79</b> ft. and in. to ft.<br>WELL WATER TO BE USED AS: <b>5</b> Public water supply <b>8</b> Air conditioning <b>11</b> Injection well<br><b>1</b> Domestic <b>3</b> Feedlot <b>6</b> Oil field water supply <b>9</b> Dewatering <b>12</b> Other (Specify below)<br><b>2</b> Irrigation <b>4</b> Industrial <b>7</b> Lawn and garden only <b>10</b> Monitoring well<br>Was a chemical/bacteriological sample submitted to Department? Yes <b>No X</b> ; If yes, mo/day/yr sample was submitted<br>Water Well Disinfected? Yes <b>X</b> No |  |                             |                                  |                                 |
| 5 TYPE OF CASING USED:<br><b>1</b> Steel <b>3</b> RMP (SR) <b>5</b> Wrought iron <b>8</b> Concrete tile CASING JOINTS: <b>Glued X Clamped</b><br><b>2</b> PVC <b>4</b> ABS <b>6</b> Asbestos-Cement <b>9</b> Other (Specify below) <b>Welded</b><br><b>7</b> Fiberglass <b>SDR-26</b> <b>Threaded</b><br>Blank casing Diameter <b>5</b> in. to <b>57</b> ft., Dia in. to ft., Dia in. to ft.<br>Casing height above land surface <b>12</b> in., weight <b>2.35</b> lbs. / ft. Wall thickness or gauge No. <b>.214</b><br>TYPE OF SCREEN OR PERFORATION MATERIAL:<br><b>1</b> Steel <b>3</b> Stainless Steel <b>5</b> Fiberglass <b>8</b> RMP (SR) <b>11</b> other (specify)<br><b>2</b> Brass <b>4</b> Galvanized steel <b>6</b> Concrete tile <b>9</b> ABS <b>12</b> None used (open hole)<br>SCREEN OR PERFORATION OPENING ARE:<br><b>1</b> Continuous slot <b>3</b> Mill slot <b>5</b> Gauzed wrapped <b>8</b> Saw cut <b>11</b> None (open hole)<br><b>2</b> Louvered shutter <b>4</b> Key punched <b>6</b> Wire wrapped <b>9</b> Drilled holes<br><b>7</b> Torch cut <b>10</b> Other (specify)<br>SCREEN-PERFORATION INTERVALS: from <b>57</b> ft. to <b>79</b> ft., From ft. to ft.<br>GRAVEL PACK INTERVALS: from <b>24</b> ft. to <b>79</b> ft., From ft. to ft.<br>from ft. to ft., From ft. to ft. |  |   |  |                             |                                  |                                 |
| 6 GROUT MATERIAL: <b>1</b> Neat cement <b>2</b> Cement grout <b>3</b> Bentonite <b>4</b> Other <b>bentonite hole plug</b><br>Grout Intervals: From <b>4</b> ft. to <b>24</b> ft. From ft. to ft. From ft. to ft.<br>What is the nearest source of possible contamination:<br><b>1</b> Septic tank <b>4</b> Lateral lines <b>7</b> Pit privy <b>10</b> Livestock pens <b>14</b> Abandon water well<br><b>2</b> Sewer lines <b>5</b> Cess pool <b>8</b> Sewage lagoon <b>11</b> Fuel storage <b>15</b> Oil well/Gas well<br><b>3</b> Watertight sewer lines <b>6</b> Seepage pit <b>9</b> Feedyard <b>12</b> Fertilizer storage <b>16</b> Other (specify below)<br><b>13</b> Insecticide storage<br>Direction from well? <b>North</b> How many feet? <b>15</b>   |  |   |  |                             |                                  |                                 |
| FROM TO LITHOLOGIC LOG FROM TO PLUGGING INTERVALS<br><b>0 3 topsoil</b><br><b>3 47 clay</b><br><b>47 57 fine sand &amp; sandstone</b><br><b>57 79 grey shale</b>   |  |   |  |                             |                                  |                                 |
| 7 CONTRACTOR'S OR LANDOWNER'S CERTIFICATION: This water well was (1) constructed, (2) reconstructed, or (3) plugged under my jurisdiction and was completed on (mo/day/year) <b>2-18-2002</b> and this record is true to the best of my knowledge and belief. Kansas Water Well Contractor's License No. <b>236</b> This Water Well Record was completed on (mo/day/yr) <b>2-20-2002</b><br>Under the business name of <b>Harp Well &amp; Pump Service, Inc</b> by (signature) <b>Todd S. Harp</b>   |  |   |  |                             |                                  |                                 |