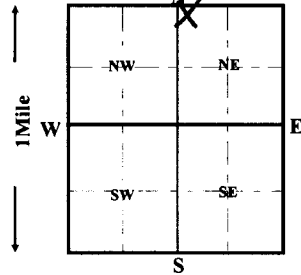


1 LOCATION OF WATER WELL: Sedgwick		FRACTION NW 1/4 NW 1/4 NE 1/4	Section Number 30	Township Number T 29 S	Range Number R 2E E/W
Distance and direction from nearest town or city street address of well if located within city? 7120 E. 111th S. Mulvane, Kansas					
WATER WELL OWNER: BUFFINGTON, Jim RR#, ST. ADDRESS, BOX #: 7120 E. 111th S. CITY, STATE, ZIP CODE: Mulvane, Kansas Board of Agriculture, Division of Water Resource Application Number:					
LOCATE WELL'S LOCATION WITH AN "X" IN SECTION BOX: 		4 DEPTH OF COMPLETED WELL 40 ft. ELEVATION: Depth(s) groundwater Encountered 1 ft. WELL'S STATIC WATER LEVEL 10 FT. BELOW LAND SURFACE MEASURED ON mo/day/yr 7-10-2002 Pump test data: Well water was _____ ft. after _____ hours pumping _____ gpm Est. Yield _____ gpm Well water was _____ ft. after _____ hours pumping _____ gpm Bore Hole Diameter 12 in. to 40 ft. and _____ in. to _____ ft. WELL WATER TO BE USED AS: 5 Public water supply 8 Air conditioning 11 Injection well 1 Domestic 3 Feedlot 6 Oil field water supply 9 Dewatering 12 Other (Specify below) 2 Irrigation 4 Industrial 7 Lawn and garden only 10 Monitoring well Was a chemical/bacteriological sample submitted to Department? Yes _____ No X ; If yes, mo/day/yr sample was submitted _____ Water Well Disinfected? Yes X No _____			
5 TYPE OF CASING USED: 1 Steel 3 RMP (SR) 5 Wrought iron 8 Concrete tile CASING JOINTS: Glued X Clamped 2 PVC 4 ABS 6 Asbestos-Cement 9 Other (Specify below) Welded Blank casing Diameter 5 in. to 25 ft., Dia _____ in. to _____ ft. Casing height above land surface 12 in., weight 2.35 lbs./ft. Wall thickness or gauge No. .214 TYPE OF SCREEN OR PERFORATION MATERIAL: 1 Steel 3 Stainless Steel 5 Fiberglass 8 RMP (SR) 11 other (specify) 2 Brass 4 Galvanized steel 6 Concrete tile 9 ABS 12 None used (open hole) SCREEN OR PERFORATION OPENING ARE: 1 Continuous slot 3 Mill slot 5 Gauzed wrapped 8 Saw cut 11 None (open hole) 2 Louvered shutter 4 Key punched 6 Wire wrapped 9 Drilled holes 3 Torch cut 10 Other (specify) SCREEN-PERFORATION INTERVALS: from 25 ft. to 40 ft., From _____ ft. to _____ ft. GRAVEL PACK INTERVALS: from 20 ft. to 40 ft., From _____ ft. to _____ ft.					
6 GROUT MATERIAL: 1 Neat cement 2 Cement grout 3 Bentonite 4 Other bentonite hole plug Grout Intervals: From 4 ft. to 24 ft. From _____ ft. to _____ ft. What is the nearest source of possible contamination: 1 Septic tank 4 Lateral lines 7 Pit privy 10 Livestock pens 14 Abandon water well 2 Sewer lines 5 Cess pool 8 Sewage lagoon 11 Fuel storage 15 Oil well/Gas well 3 Watertight sewer lines 6 Seepage pit 9 Feedyard 12 Fertilizer storage 16 Other (specify below) Direction from well? _____ How many feet? _____ FROM TO LITHOLOGIC LOG FROM TO PLUGGING INTERVALS 0 4 topsoil 4 15 clay 15 25 medium fine sand 25 40 shale					
7 CONTRACTOR'S OR LANDOWNER'S CERTIFICATION: This water well was (1) constructed, (2) reconstructed, or (3) plugged under my jurisdiction and was completed on (mo/day/year) 7-10-2002 and this record is true to the best of my knowledge and belief. Kansas Water Well Contractor's License No. 236 This Water Well Record was completed on (mo/day/yr) 7-12-2002 Under the business name of Harp Well & Pump Service, Inc by (signature) <i>Todd S. Harp</i>					