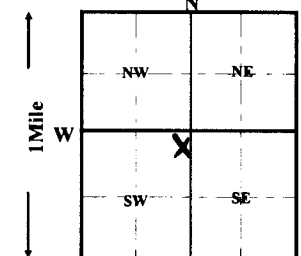


|   |  |   |  |                            |  |                                  |  |                                |  |
|---|--|---|--|----------------------------|--|----------------------------------|--|--------------------------------|--|
| 1 LOCATION OF WATER WELL:<br><b>Sedgwick</b>   |  | FRACTION <b>SW NW NE SW</b><br><b>1/4 1/4 1/4 1/4</b>   |  | Section Number<br><b>5</b> |  | Township Number<br><b>T 29 S</b> |  | Range Number<br><b>R 2E EW</b> |  |
| Distance and direction from nearest town or city street address of well if located within city?<br><b>2100 Myrtlewood Circle Derby, Kansas</b>   |  |   |  |                            |  |                                  |  |                                |  |
| WATER WELL OWNER: <b>SPRINGER, Justin</b><br>RR#, ST. ADDRESS, BOX #: <b>2100 Myrtlewood Circle</b><br>CITY, STATE, ZIP CODE: <b>Derby, Kansas</b><br>Board of Agriculture, Division of Water Resource<br>Application Number:   |  |   |  |                            |  |                                  |  |                                |  |
| LOCATE WELL'S LOCATION WITH AN "X" IN SECTION BOX:<br>   |  | 4 DEPTH OF COMPLETED WELL <b>63</b> ft. ELEVATION:<br>Depth(s) groundwater Encountered <b>1</b> ft. <b>2</b> ft. <b>3</b> ft.<br>WELL'S STATIC WATER LEVEL <b>45</b> FT. BELOW LAND SURFACE MEASURED ON <b>mo/day/yr 1-27-2003</b><br>Pump test data: Well water was <b>ft. after</b> <b>hours pumping</b> <b>gpm</b><br>Est. Yield <b>gpm:</b> Well water was <b>ft. after</b> <b>hours pumping</b> <b>gpm</b><br>Bore Hole Diameter <b>12</b> in. to <b>63</b> ft. and in. to ft.<br>WELL WATER TO BE USED AS: <b>5</b> Public water supply <b>8</b> Air conditioning <b>11</b> Injection well<br><b>1</b> Domestic <b>3</b> Feedlot <b>6</b> Oil field water supply <b>9</b> Dewatering <b>12</b> Other (Specify below)<br><b>2</b> Irrigation <b>4</b> Industrial <b>7</b> Lawn and garden only <b>10</b> Monitoring well<br>Was a chemical/bacteriological sample submitted to Department? Yes <b>No X</b> ; If yes, mo/day/yr sample was submitted<br>Water Well Disinfected? Yes <b>X</b> No |  |                            |  |                                  |  |                                |  |
| 5 TYPE OF CASING USED:<br><b>1</b> Steel <b>3</b> RMP (SR)<br><b>2</b> PVC <b>4</b> ABS<br>Blank casing Diameter <b>5</b> in. to <b>45</b> ft., Dia in. to ft.<br>Casing height above land surface <b>12</b> in., weight <b>2.35</b> lbs. / ft. Wall thickness or gauge No. <b>.214</b><br>TYPE OF SCREEN OR PERFORATION MATERIAL:<br><b>1</b> Steel <b>3</b> Stainless Steel <b>5</b> Fiberglass <b>8</b> RMP (SR)<br><b>2</b> Brass <b>4</b> Galvanized steel <b>6</b> Concrete tile <b>9</b> ABS<br>SCREEN OR PERFORATION OPENING ARE:<br><b>1</b> Continuous slot <b>3</b> Mill slot <b>5</b> Gauzed wrapped <b>8</b> Saw cut <b>11</b> None (open hole)<br><b>2</b> Louvered shutter <b>4</b> Key punched <b>6</b> Wire wrapped <b>9</b> Drilled holes<br><b>7</b> Torch cut <b>10</b> Other (specify)<br>SCREEN-PERFORATION INTERVALS: from <b>45</b> ft. to <b>63</b> ft., From ft. to ft.<br>GRAVEL PACK INTERVALS: from <b>24</b> ft. to <b>63</b> ft., From ft. to ft.<br>from ft. to ft., From ft. to ft. |  |   |  |                            |  |                                  |  |                                |  |
| 6 GROUT MATERIAL: <b>1</b> Neat cement <b>2</b> Cement grout <b>3</b> Bentonite <b>4</b> Other <b>bentonite hole plug</b><br>Grout Intervals: From <b>4</b> ft. to <b>24</b> ft. From ft. to ft. From ft. to ft.<br>What is the nearest source of possible contamination:<br><b>1</b> Septic tank <b>4</b> Lateral lines <b>7</b> Pit privy <b>10</b> Livestock pens <b>14</b> Abandon water well<br><b>2</b> Sewer lines <b>5</b> Cess pool <b>8</b> Sewage lagoon <b>11</b> Fuel storage <b>15</b> Oil well/Gas well<br><b>3</b> Watertight sewer lines <b>6</b> Seepage pit <b>9</b> Feedyard <b>12</b> Fertilizer storage <b>16</b> Other (specify below)<br><b>13</b> Insecticide storage<br>Direction from well? <b>West</b> How many feet? <b>40</b>   |  |   |  |                            |  |                                  |  |                                |  |
| FROM TO LITHOLOGIC LOG FROM TO PLUGGING INTERVALS<br>0 3 topsoil<br>3 25 clay<br>25 29 sandy clay<br>29 63 grey shale   |  |   |  |                            |  |                                  |  |                                |  |
| 7 CONTRACTOR'S OR LANDOWNER'S CERTIFICATION: This water well was (1) constructed, (2) reconstructed, or (3) plugged under my jurisdiction and was completed on (mo/day/year) <b>1-27-2003</b> and this record is true to the best of my knowledge and belief. Kansas Water Well Contractor's License No. <b>236</b> This Water Well Record was completed on (mo/day/yr) <b>1-29-2003</b><br>Under the business name of <b>Harp Well &amp; Pump Service, Inc</b> by (signature) <b>Todd S. Harp</b>   |  |   |  |                            |  |                                  |  |                                |  |