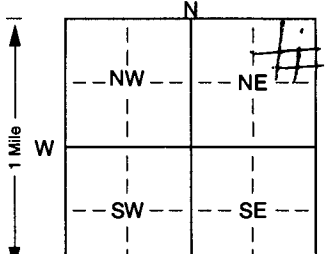


1 LOCATION OF WATER WELL: County: <u>Sedgwick</u> Fraction: <u>1/4</u> <u>1/4</u> <u>1/4</u> <u>1/4</u> Section Number: <u>6</u> Township Number: <u>29</u> Range Number: <u>2</u> EW	
Distance and direction from nearest town or city street address of well if located within city? <u>In City Derby</u>	
2 WATER WELL OWNER: <u>SHILLA MILLER Derby Kan</u> RR#, St. Address, Box # : <u>801 Park Lane, 67037</u> Board of Agriculture, Division of Water Resources City, State, ZIP Code : <u>67037</u> Application Number:	
(lawn & garden) 10 Monitoring well Was a chemical/bacteriological sample submitted to Department? Yes. <u>X</u> No. <u>X</u> ; If yes, mo/day/yr sample was submitted Water Well Disinfected? Yes <u>X</u> No
5 TYPE OF BLANK CASING USED: 1 Steel 3 RMP (SR) 5 Wrought iron 8 Concrete tile CASING JOINTS: Glued <u>X</u> Clamped 2 PVC 4 ABS 6 Asbestos-Cement 9 Other (specify below) Welded Blank casing diameter <u>5</u> in. hole) SCREEN OR PERFORATION OPENINGS ARE: 1 Continuous slot 3 Mill slot 5 Gauzed wrapped 8 Saw cut 11 None (open hole) 2 Louvered shutter 4 Key punched 6 Wire wrapped 9 Drilled holes 7 Torch cut 10 Other (specify) SCREEN-PERFORATED INTERVALS: From <u>60</u> ft. 
well/Gas well <u>3</u> Watertight sewer lines 6 Seepage pit 9 Feedyard 12 Fertilizer storage 16 Other (specify below) Direction from well? <u>N</u> How many feet? <u>100</u>	
7 CONTRACTOR'S OR LANDOWNER'S CERTIFICATION: This water well was <u>1</u> constructed, (2) reconstructed, or (3) plugged under my jurisdiction and was completed on (mo/day/year) <u>9/19/03</u> and this record is true to the best of my knowledge and belief. Kansas Water Well Contractor's Licence No. <u>251</u> This Water Well Record was completed on (mo/day/yr) <u>9/30/03</u> under the business name of <u>Winter Well Drilling</u> by (signature) <u>Charles Winter</u>	
INSTRUCTIONS: Use typewriter or ball point pen. PLEASE PRESS FIRMLY and PRINT clearly. Please fill in blanks, underline or circle the correct answers. Send top three copies to Kansas Department of Health and Environment, Bureau of Water, Topeka, Kansas 66620-0001. Telephone 785-296-5524. Send one to WATER WELL OWNER and retain one for your records. Fee of \$5.00 for each constructed well.	