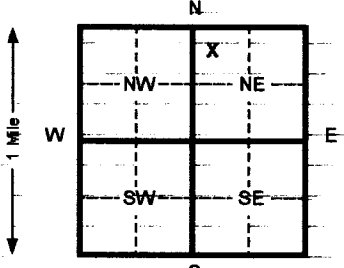


1 LOCATION OF WATER WELL:		Fraction	Section Number		Township Number		Range Number	
County: SEDGWICK		NE 1/4 SE NE 1/4	18		T 29S S		R 2E E/W	
Distance and direction from nearest town or city street address of well if located within city? 1417 BOX ELDER CT.; DERBY, KS								
2 WATER WELL OWNER: WAYNE FLOWERDAY								
RR#, St. Address, Box # : 1417 BOX ELDER CT. Board of Agriculture, Division of Water Resources								
City, State, ZIP Code : DERBY, KS Application Number:								
3 LOCATE WELL'S LOCATION WITH AN "X" IN SECTION BOX:			4 DEPTH OF COMPLETED WELL 80 ft. ELEVATION:					
			Depth(s) Groundwater Encountered: 1 30 ft. 2 _____ ft. 3 _____ ft. WELL'S STATIC WATER LEVEL 30 ft. below land surface measured on mo/day/yr 9-5-03 Pump test data: Well water was _____ ft. after _____ hours pumping _____ gpm Est. Yield _____ gpm: Well water was _____ ft. after _____ hours pumping _____ gpm Bore Hole Diameter 10 in. to 80 ft. and _____ in. to _____ ft. WELL WATER TO BE USED AS: 5 Public water supply 8 Air conditioning 11 Injection well 1 Domestic 3 Feed lot 6 Oil field water supply 9 Dewatering 12 Other (Specify below) 2 Irrigation 4 Industrial 7 Lawn and garden (domestic) 10 Monitoring well Was a chemical/bacteriological sample submitted to Department? Yes _____ No X If yes, mo/day/yr sample was submitted _____ Water Well Disinfected? Yes X No _____					
5 TYPE OF BLANK CASING USED:								
1 Steel 3 RMP (SR) 5 Wrought Iron 8 Concrete tile CASING JOINTS: Glued X Clamped _____								
2 PVC 4 ABS 6 Asbestos-Cement 9 Other (specify below) Welded _____								
7 Fiberglass _____ Threaded _____								
Blank casing diameter 5 in. to 80 ft. Dia _____ in. to _____ ft. Dia _____ in. to _____ ft.								
Casing height above land surface 16 in. weight 160 lbs./ft. Wall thickness or gauge No. 26								
TYPE OF SCREEN OR PERFORATION MATERIAL:								
1 Steel 3 Stainless steel 5 Fiberglass 8 PVC 10 Asbestos-cement								
2 Brass 4 Galvanized steel 6 Concrete tile 9 ABS 11 Other (specify) _____								
12 None used (open hole) _____								
SCREEN OR PERFORATION OPENINGS ARE:								
1 Continuous slot 3 Mill slot 5 Gauzed wrapped 8 Saw cut 11 None (open hole)								
2 Louvered shutter 4 Key punched 6 Wire wrapped 9 Drilled holes								
7 Torch cut 10 Other (specify) _____								
SCREEN-PERFORATED INTERVALS: From 40 ft. to 80 ft. From _____ ft. to _____ ft.								
From _____ ft. to _____ ft. From _____ ft. to _____ ft.								
GRAVEL PACK INTERVALS: From 25 ft. to 80 ft. From _____ ft. to _____ ft.								
From _____ ft. to _____ ft. From _____ ft. to _____ ft.								
6 GROUT MATERIAL: 1 Neat cement 2 Cement grout 3 Bentonite 4 Other _____								
Grout Intervals From 4 ft. to 25 ft. From _____ ft. to _____ ft. From _____ ft. to _____ ft.								
What is the nearest source of possible contamination:								
1 Septic tank 4 Lateral lines 7 Pit privy 10 Livestock pens 14 Abandoned water well								
2 Sewer lines 5 Cess pool 8 Sewage lagoon 11 Fuel storage 15 Oil well/ Gas well								
3 Watertight sewer lines 6 Seepage pit 9 Feedyard 12 Fertilizer storage 16 Other (specify below) _____								
13 Insecticide storage _____								
Direction from well? EAST How many feet? 40								
FROM TO CODE LITHOLOGIC LOG FROM TO PLUGGING INTERVALS								
0 2 TOPSOIL								
2 27 CLAY								
27 36 MED/FINE SAND								
36 42 SHALE								
42 67 LIMESTONE								
67 80 SHALE								
7 CONTRACTOR'S OR LANDOWNER'S CERTIFICATION: This water well was (1) constructed , (2) reconstructed, or (3) plugged under my jurisdiction and was completed on (mo/day/yr) 9-5-03 and this record is true to the best of my knowledge and belief. Kansas								
Water Well Contractor's License No. 611 This Water Well Record was completed on (mo/day/yr) 9-5-03								
under the business name of Chase Drilling by (signature) RICK CHASE								
INSTRUCTIONS: Please fill in blanks and circle the correct answers. Send three copies to Kansas Department of Health and Environment, Bureau of Water, 1000 SW Jackson St., Ste. 420, Topeka, Kansas 66612-1367. Telephone: 913-296-5545. Send one to WATER WELL OWNER and retain one for your records.								

OFFICE USE ONLY

1

२

SEC