WATER WELL RECORD Form WWC-5 KSA 82a-1212 ID No. _____

1 LOCATION OF WATER WELL:

County:	Fraction	Section Number	Township Number	Range Number
SEDGWICK	SW ¼ NW ¼ NW ¼	18	T 29S S	R 2E E/W

Distance and direction from nearest town or city street address of well if located within city?
1025 E. HAWTHORNE CT.; DERBY

2 WATER WELL OWNER: ROBERT LEWALLAN
RR#, St. Address, Box # : 1025 E. HAWTHORNE CT.
City, State, ZIP Code : DERBY, KS

Board of Agriculture, Division of Water Resources
Application Number:

3 LOCATE WELL'S LOCATON WITH AN "X" IN SECTION BOX:

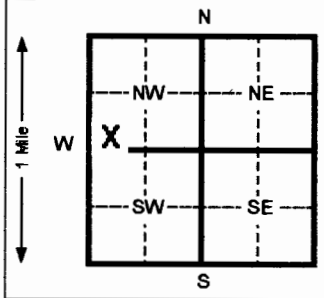

4 DEPTH OF COMPLETED WELL 80 ft. ELEVATION: _____

Depth(s) Groundwater Encountered 1 30 ft. 2 _____ ft. 3 _____ ft.

WELL'S STATIC WATER LEVEL 30 ft. below land surface measured on mo/day/yr 10-29-03

Pump test data: Well water was _____ ft. after _____ hours pumping _____ gpm

Est. Yield _____ gpm: Well water was _____ ft. after _____ hours pumping _____ gpm

Bore Hole Diameter 10 in. to 80 ft. and _____ in. to _____ ft.

WELL WATER TO BE USED AS: 1 Domestic 3 Feed lot 5 Public water supply 8 Air conditioning 11 Injection well
2 Irrigation 4 Industrial 6 Oil field water supply 9 Dewatering 12 Other (Specify below)
7 Lawn and garden (domestic) 10 Monitoring well _____

Was a chemical/bacteriological sample submitted to Department? Yes _____ No X If yes, mo/day/yr sample was submitted _____

Water Well Disinfected? Yes X No

5 TYPE OF BLANK CASING USED:
1 Steel 3 RMP (SR) 5 Wrought Iron 8 Concrete tile
2 PVC 4 ABS 6 Asbestos-Cement 9 Other (specify below) 7 Fiberglass _____

CASING JOINTS: Glued X Clamped _____ Welded _____ Threaded _____

Blank casing diameter 5 in. to 80 ft., Dia _____ in. to _____ ft., Dia _____ in. to _____ ft.

Casing height above land surface 16 in., weight 160 lbs./ft. Wall thickness or gauge No. 26

TYPE OF SCREEN OR PERFORATION MATERIAL:
1 Steel 3 Stainless steel 5 Fiberglass 7 PVC 10 Asbestos-cement
2 Brass 4 Galvanized steel 6 Concrete tile 8 RMP (SR) 9 ABS 11 Other (specify) _____ 12 None used (open hole)

SCREEN OR PERFORATION OPENINGS ARE:
1 Continuous slot 3 Mill slot 5 Gauzed wrapped 8 Saw cut 11 None (open hole)
2 Louvered shutter 4 Key punched 6 Wire wrapped 9 Drilled holes
7 Torch cut 10 Other (specify) _____

SCREEN-PERFORATED INTERVALS: From 40 ft. to 80 ft. From _____ ft. to _____ ft.
From _____ ft. to _____ ft. From _____ ft. to _____ ft.

GRAVEL PACK INTERVALS: From 25 ft. to 80 ft. From _____ ft. to _____ ft.
From _____ ft. to _____ ft. From _____ ft. to _____ ft.

6 GROUT MATERIAL: 1 Neat cement 2 Cement grout 3 Bentonite 4 Other _____

Grout Intervals From 4 ft. to 24 ft. From _____ ft. to _____ ft. From _____ ft. to _____ ft.

What is the nearest source of possible contamination:
1 Septic tank 4 Lateral lines 7 Pit privy 10 Livestock pens 14 Abandoned water well
2 Sewer lines 5 Cess pool 8 Sewage lagoon 11 Fuel storage 15 Oil well/ Gas well
3 Watertight sewer lines 6 Seepage pit 9 Feedyard 12 Fertilizer storage 16 Other (specify below)
13 Insecticide storage _____

Direction from well? EAST How many feet? 40

FROM	TO	CODE	LITHOLOGIC LOG	FROM	TO	PLUGGING INTERVALS
0	2		TOPSOIL			
2	27		CLAY			
27	36		MED/FINE SAND			
36	42		SHALE			
42	67		LIMESTONE			
67	80		SHALE			

7 CONTRACTOR'S OR LANDOWNER'S CERTIFICATION: This water well was (1) constructed, (2) reconstructed, or (3) plugged under my jurisdiction and was completed on (mo/day/yr) 10-29-03 and this record is true to the best of my knowledge and belief. Kansas Water Well Contractor's License No. 611 This Water Well Record was completed on (mo/day/yr) 10-29-03 under the business name of CHASE DRILLING by (signature) RICK CHASE

INSTRUCTIONS:. Please fill in blanks and circle the correct answers. Send three copies to Kansas Department of Health and Environment, Bureau of Water, 1000 S W Jackson St., Ste. 420, Topeka, Kansas 66612-1367. Telephone: 913-296-5545. Send one to WATER WELL OWNER and retain one for your records.

OFFICE USE ONLY T R SEC

Form provided by Forms-On-A-Disk, Inc. · Dallas, Texas · (214) 340-9429