

SW SW NE NW

CORRECTED LOG WELL

WATER WELL RECORD Form WWC-5 KSA 82a-1212 ID No.

LOCATION OF WATER WELL: Fraction ~~NW~~ $\frac{1}{4}$ ~~NE~~ $\frac{1}{4}$ ~~NW~~ $\frac{1}{4}$ Section Number 6 Township Number T 29S S Range Number R 2E EW

Distance and direction from nearest town or city street address of well if located within city?

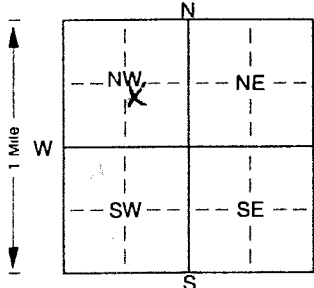
1233 Armstrong Ave; DerbyWELL OWNER Judy MiddlebrookR#, St. Address, Box # : 1233 Armstrong AveCity, State, ZIP Code : Derby, KS

Board of Agriculture, Division of Water Resources

Application Number:

LOCATE WELL'S LOCATION WITH 4 DEPTH OF COMPLETED WELL 90 ft. ELEVATION:

AN "X" IN SECTION BOX:

Depth(s) Groundwater Encountered 1 27 ft. 2. ft. 3. ft.WELL'S STATIC WATER LEVEL 27 ft. below land surface measured on mo/day/yr 2-21-04

Pump test data: Well water was ft. after hours pumping gpm

Est. Yield gpm: Well water was ft. after hours pumping gpm

Bore Hole Diameter 10 in. to 90 ft. and in. to ft.

WELL WATER TO BE USED AS: 5 Public water supply 8 Air conditioning 11 Injection well

1 Domestic 3 Feedlot 6 Oil field water supply 9 Dewatering 12 Other (Specify below)2 Irrigation 4 Industrial 7 Domestic (lawn & garden) 10 Monitoring wellWas a chemical/bacteriological sample submitted to Department? Yes. No. X; If yes, mo/day/yr sample was submittedWater Well Disinfected? Yes X NoTYPE OF BLANK CASING USED: 5 Wrought iron 8 Concrete tile CASING JOINTS: Glued X Clamped.1 Steel 3 RMP (SR) 6 Asbestos-Cement 9 Other (specify below) Welded2 PVC 4 ABS 7 Fiberglass ThreadedBlank casing diameter 5 in. to 90 ft. Dia. in. to ft. Dia. in. toCasing height above land surface 16 in., weight 1100 lbs./ft. Wall thickness or gauge No. 26TYPE OF SCREEN OR PERFORATION MATERIAL: 7 PVC 10 Asbestos-cement

1 Steel 3 Stainless steel 5 Fiberglass 8 RMP (SR) 11 Other (specify)

2 Brass 4 Galvanized steel 6 Concrete tile 9 ABS 12 None used (open hole)

SCREEN OR PERFORATION OPENINGS ARE: 5 Gauzed wrapped 8 Saw cut 11 None (open hole)

1 Continuous slot 3 Mill slot 6 Wire wrapped 9 Drilled holes

2 Louvered shutter 4 Key punched 7 Torch cut 10 Other (specify)

SCREEN-PERFORATED INTERVALS: From 50 ft. to 90 ft. From ft. to

From ft. to ft. From ft. to

GRAVEL PACK INTERVALS: From 24 ft. to 90 ft. From ft. to

From ft. to ft. From ft. to

GROUT MATERIAL: 1 Neat cement 2 Cement grout 3 Bentonite 4 OtherGrout Intervals: From 4 ft. to 24 ft. From ft. to ft. to ft.

What is the nearest source of possible contamination: 10 Livestock pens 14 Abandoned water well

1 Septic tank 4 Lateral lines 7 Pit privy 11 Fuel storage 15 Oil well/Gas well

2 Sewer lines 5 Cess pool 8 Sewage lagoon 12 Fertilizer storage 16 Other (specify below)

3 Watertight sewer lines 6 Seepage pit 9 Feedyard 13 Insecticide storage

Direction from well? North How many feet? 40

FROM TO LITHOLOGIC LOG FROM TO PLUGGING INTERVALS

0 2 Topsoil2 32 clay32 45 med/coarse sand/gravel45 90 blue shale/limestoneCONTRACTOR'S OR LANDOWNER'S CERTIFICATION: This water well was (1) constructed, (2) reconstructed, or (3) plugged under my jurisdiction and was completed on (mo/day/year) 2-21-04 8/14/03 and this record is true to the best of my knowledge and belief. KansasWater Well Contractor's Licence No. 1611 This Water Well Record was completed on (mo/day/yr) 2-21-04Under the business name of Chase Drilling by (signature) Rich Chase

INSTRUCTIONS: Use typewriter or ball point pen. PLEASE PRESS FIRMLY and PRINT clearly. Please fill in blanks, underline or circle the correct answers. Send top three copies to Kansas Department of Health and Environment, Bureau of Water, Topeka, Kansas 66620-0001. Telephone 785-296-5524. Send one to WATER WELL OWNER and retain one for your records. Fee of \$5.00 for each constructed well.