


1 LOCATION OF WATER WELL: County: <u>Sedgwick</u>	Fraction <u>SW</u> $\frac{1}{4}$ <u>SE</u> $\frac{1}{4}$ <u>NW</u> $\frac{1}{4}$	Section Number <u>18</u>	Township Number T <u>29</u> S	Range Number R <u>20</u> EW
--	---	-----------------------------	----------------------------------	--------------------------------

Distance and direction from nearest town or city street address, or well if located within city?
1013 Rushmore Dr Derby

2 WATER WELL OWNER: Remax Realty - Farris, Brandy
RR#, St. Address, Box # : 1013 Rushwood Dr.
City, State, ZIP Code : Delph, KS 67037 22

Board of Agriculture, Division of Water Resources
Application Number:

3 LOCATE WELL'S LOCATION WITH 4 DEPTH OF COMPLETED WELL 90 ft. ELEVATION:

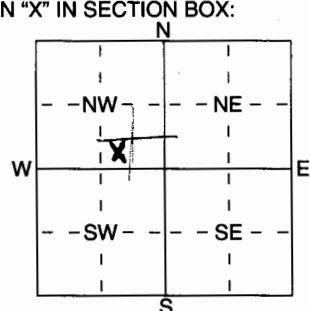

Depth(s) Groundwater Encountered 22 ft. 2 _____ ft. 3 _____ ft.
WELL'S STATIC WATER LEVEL 22 ft. below land surface measured on mo/day/yr _____
Pump test data: Well water was _____ ft. after _____ hours pumping _____ gpm
Est. Yield _____ gpm: Well water was _____ ft. after _____ hours pumping _____ gpm
WELL WATER TO BE USED AS:
1 Domestic 3 Feedlot 5 Public water supply 8 Air conditioning 11 Injection well
2 Irrigation 4 Industrial 6 Oil field water supply 9 Dewatering 12 Other (Specify below)
7 Domestic (lawn & garden) 10 Monitoring well _____

Was a chemical/bacteriological sample submitted to Department? Yes No ✓.....; If yes, mo/day/yr sample was submitted
Water Well Disinfected? Yes ✓..... No

5	TYPE OF BLANK CASING USED:	5 Wrought iron	8 Concrete tile	CASING JOINTS: Glued ☒ Clamped ☐
	1 Steel	6 Asbestos-Cement	9 Other (specify below)	Welded ☐
	2 PVC	7 Fiberglass		Threaded ☐
	3 RMP (SR)			
	4 ABS			

Blank casing diameter in. to ft., Dia in. to ft., Dia in. to ft.
Casing height above land surface 16 in., weight 160 lbs./ft. Wall thickness or gauge No. 26

TYPE OF SCREEN OR PERFORATION MATERIAL:				<u>PVC</u>	10 Asbestos-Cement
1 Steel	3 Stainless Steel	5 Fiberglass	8 RMP (SR)	11 Other (Specify)	
2 Brass	4 Galvanized Steel	6 Concrete tile	9 ABS	12 None used (open hole)	

SCREEN OR PERFORATION OPENINGS ARE:

1 Continuous slot	3 Mill slot	5 Gauzed wrapped	8 Saw cut	11 None (open hole)
2 Louvered shutter	4 Key punched	6 Wire wrapped	9 Drilled holes	
		7 Torch cut	10 Other (specify)	ft.

SCREEN PERFORATED INTERNALS: 5 in. 60 ft. 80 ft. 5 in. ft. 5 in. ft.

SCREEN-PERFORATED INTERVALS: From 20 ft. to 80 ft., From ft. to ft.
From ft. to ft., From ft. to ft.
GRAVEL PACK INTERVALS: From 25 ft. to 80 ft., From ft. to ft.
From ft. to ft., From ft. to ft.

6 GROUT MATERIAL: 1 Neat cement 2 Cement grout 3 Bentonite 4 Other _____
Grout Intervals: From 4 ft. to 24 ft., From _____ ft. to _____ ft., From _____ ft. to _____ ft.

What is the nearest source of possible contamination:

1 Septic tank	4 Lateral lines	7 Pit privy	10 Livestock pens	14 Abandoned water well
2 Sewer lines	5 Cess pool	8 Sewage lagoon	11 Fuel storage	15 Oil well/Gas well
3 Watertight sewer lines	6 Seepage pit	9 Feedyard	12 Fertilizer storage	16 Other (specify below)
13 Insecticide storage				

Direction from well? South

How many feet? 15'

[illegible]

7. CONTRACTOR'S OR LANDOWNER'S CERTIFICATION: This water well was (1) constructed, (2) reconstructed, or (3) plugged under my jurisdiction and was completed on (mo/day/year) 12/9/05 and this record is true to the best of my knowledge and belief. Kansas Water Well Contractor's Licence No. 6-11 This Water Well Record was completed on (mo/day/yr) 5/20/06 under the business name of Chase Drilling by (signature) D. Chase