

WATER WELL RECORD Form WWC-5


Original Record Correction Change in Well Use

Division of Water
Resources App. No.

Well ID

1 LOCATION OF WATER WELL: County: <u>Sedgewick</u>	Fraction - <u>SW 1/4 SE 1/4 NW 1/4</u>	Section Number <u>29</u>	Township Number <u>T 29 S</u>	Range Number <u>R 2 E</u>
--	--	--------------------------	-------------------------------	---------------------------

2 WELL OWNER: Last Name: <u>Wichita Mulane</u> Business: <u>Irrigation Unlimited</u> Address: <u>938 Corey Rd</u> Address: <u>Hutchinson</u> State: <u>KS</u> ZIP: <u>67562</u>	Street or Rural Address where well is located (if unknown, distance and direction from nearest town or intersection): If at owner's address, check here: <input type="checkbox"/> <u>1705 Country Walk</u>
---	---

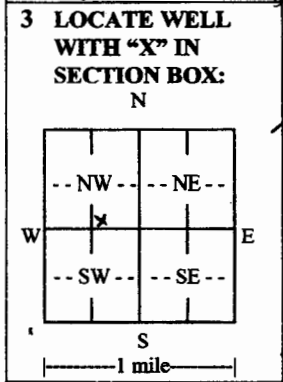

4 DEPTH OF COMPLETED WELL: 100 ft.

Depth(s) Groundwater Encountered: 1) ft.
 2) ft. 3) ft., or 4 Dry Well

WELL'S STATIC WATER LEVEL: 34 ft. 9/2/15

below land surface, measured on (mo-day-yr)
 above land surface, measured on (mo-day-yr)

Pump test data: Well water was ft. after hours pumping gpm
 Well water was ft. after hours pumping gpm

Estimated Yield: gpm
 Bore Hole Diameter: 9 in. to 100 ft. and in. to ft.

5 Latitude: (decimal degrees)
Longitude: (decimal degrees)
 Datum: WGS 84 NAD 83 NAD 27
 Source for Latitude/Longitude:
 GPS (unit make/model:)
 (WAAS enabled? Yes No)
 Land Survey Topographic Map
 Online Mapper:

6 Elevation: ft. Ground Level TOC
 Source: Land Survey GPS Topographic Map
 Other

7 WELL WATER TO BE USED AS:

1. <input type="checkbox"/> Domestic: <input type="checkbox"/> Household <input checked="" type="checkbox"/> Lawn & Garden <input type="checkbox"/> Livestock	5. <input type="checkbox"/> Public Water Supply: well ID	10. <input type="checkbox"/> Oil Field Water Supply: lease
2. <input type="checkbox"/> Irrigation	6. <input type="checkbox"/> Dewatering: how many wells?	11. Test Hole: well ID
3. <input type="checkbox"/> Feedlot	7. <input type="checkbox"/> Aquifer Recharge: well ID	<input type="checkbox"/> Cased <input type="checkbox"/> Uncased <input type="checkbox"/> Geotechnical
4. <input type="checkbox"/> Industrial	8. <input type="checkbox"/> Monitoring: well ID	12. Geothermal: how many bores?
	9. Environmental Remediation: well ID	a) Closed Loop <input type="checkbox"/> Horizontal <input type="checkbox"/> Vertical
	<input type="checkbox"/> Air Sparge <input type="checkbox"/> Soil Vapor Extraction	b) Open Loop <input type="checkbox"/> Surface Discharge <input type="checkbox"/> Inj. of Water
	<input type="checkbox"/> Recovery <input type="checkbox"/> Injection	13. <input type="checkbox"/> Other (specify):

Was a chemical/bacteriological sample submitted to KDHE? Yes No If yes, date sample was submitted:

Water well disinfected? Yes No

8 TYPE OF CASING USED: Steel PVC Other CASING JOINTS: Glued Clamped Welded Threaded

Casing diameter 5 in. to ft. Diameter in. to ft. Diameter in. to ft.
 Casing height above land surface 12 in. Weight lbs./ft. Wall thickness or gauge No. 110 psi

TYPE OF SCREEN OR PERFORATION MATERIAL:
 Steel Stainless Steel Fiberglass PVC Other (Specify)
 Brass Galvanized Steel Concrete tile None used (open hole)

SCREEN OR PERFORATION OPENINGS ARE:
 Continuous Slot Mill Slot Gauze Wrapped Torch Cut Drilled Holes Other (Specify)
 Louvered Shutter Key Punched Wire Wrapped Saw Cut None (Open Hole)

SCREEN-PERFORATED INTERVALS: From 29 ft. to 100 ft. From ft. to ft. From ft. to ft.
 GRAVEL PACK INTERVALS: From ft. to ft. From ft. to ft. From ft. to ft.

9 GROUT MATERIAL: Neat cement Cement grout Bentonite Other

Grout Intervals: From 3 ft. to 29 ft. From ft. to ft. From ft. to ft.

Nearest source of possible contamination:
 Septic Tank Lateral Lines Pit Privy Livestock Pens Insecticide Storage
 Sewer Lines Cess Pool Sewage Lagoon Fuel Storage Abandoned Water Well
 Watertight Sewer Lines Seepage Pit Feedyard Fertilizer Storage Oil Well/Gas Well
 Other (Specify)

Direction from well? South East Distance from well? 75+ ft.

10 FROM	TO	LITHOLOGIC LOG	FROM	TO	LITHO. LOG (cont.) or PLUGGING INTERVALS
0	1	Top Soil			
1	45	Clay			
45	47	fine sand			
47	59	med sand			
59	94	Shale			
94	98	limestone Rock			
98	100	Shale			

Notes:

11 CONTRACTOR'S OR LANDOWNER'S CERTIFICATION: This water well was constructed, reconstructed, or plugged under my jurisdiction and was completed on (mo-day-year) 9/2/15 and this record is true to the best of my knowledge and belief.
 Kansas Water Well Contractor's License No. 884 This Water Well Record was completed on (mo-day-year) 9.23.15
 under the business name of Wichita Drilling, LLC