

WATER WELL RECORD Form WWC-5


Division of Water Resources App. No. 126

Well ID 126

Original Record Correction Change in Well Use

1 LOCATION OF WATER WELL: County: Sedgwick Fraction: 1/4 NW 1/4 SE 1/4 NW 1/4 Section Number: 18 Township Number: T 29 S Range Number: R 2 E W N

2 WELL OWNER: Last Name: Grossen First: Marie Street or Rural Address where well is located (if unknown, distance and direction from nearest town or intersection): If at owner's address, check here:
 Business Address: 1036 E Rushwood hls
 City: Meriden State: Ks ZIP: 67037

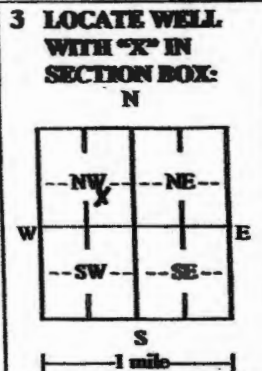

4 DEPTH OF COMPLETED WELL: 80 ft.
 Depth(s) Groundwater Encountered: 1) 32 ft.
 2) 32 ft. 3) _____ ft., or 4) Dry Well
WELL'S STATIC WATER LEVEL: _____ ft.
 below land surface, measured on (no-day-yr) _____
 above land surface, measured on (no-day-yr) 8-10-15
 Pump test data: Well water was _____ ft. after _____ hours pumping _____ gpm
 Well water was _____ ft. after _____ hours pumping _____ gpm
 Estimated Yield: 20 gpm
 Bore Hole Diameter: 12 in. to 80 ft. and _____ in. to _____ ft.

5 Latitude: _____ (decimal degrees)
Longitude: _____ (decimal degrees)
 Datum: WGS 84 NAD 83 NAD 27
 Source for Latitude/Longitude:
 GPS (unit make/model: _____) (WAAS enabled? Yes No)
 Land Survey Topographic Map
 Online Mapper: _____

6 Elevation: _____ ft. Ground Level TOC
 Source: Land Survey GPS Topographic Map
 Other: _____

7 WELL WATER TO BE USED AS:

1. Domestic: Household Lawn & Garden Livestock
 Irrigation
 Feedlot
 Industrial

2. Public Water Supply: well ID _____
 Dewatering: how many wells? _____
 Aquifer Recharge: well ID _____
 Monitoring: well ID _____
 Environmental Remediation: well ID _____
 Air Sparge Soil Vapor Extraction Recovery Injection

10. Oil Field Water Supply: lease _____
 11. Test Hole: well ID _____
 Cased Uncased Geotechnical
 12. Geothermal: how many bores? _____
 a) Closed Loop Horizontal Vertical
 b) Open Loop Surface Discharge: Inj. of Water
 13. Other (specify): _____

Was a chemical/bacteriological sample submitted to KDHE? Yes No If yes, date sample was submitted: _____
 Water well disinfected? Yes No

8 TYPE OF CASING USED: Steel PVC Other _____ CASING JOINTS: Glued Clamped Welded Threaded
 Casing diameter 5 in. to 80 ft., Diameter _____ in. to _____ ft., Diameter _____ in. to _____ ft.
 Casing height above land surface 16 in. Weight 160 lbs./ft. Wall thickness or gauge No. 26

TYPE OF SCREEN OR PERFORATION MATERIAL:
 Steel Stainless Steel Fiberglass PVC Other (Specify) _____
 Brass Galvanized Steel Concrete tile None used (open hole)

SCREEN OR PERFORATION OPENINGS ARE:
 Continuous Slot Mill Slot Gauge Wrapped Torch Cut Drilled Holes Other (Specify) _____
 Louvered Slotted Key Punched Wire Wrapped Saw Cut None (Open Hole)

SCREEN-PERFORATED INTERVALS: From 40 ft. to 80 ft., From _____ ft. to _____ ft., From _____ ft. to _____ ft.
GRAVEL PACK INTERVALS: From 24 ft. to 80 ft., From _____ ft. to _____ ft., From _____ ft. to _____ ft.

9 GROUT MATERIAL: Neat cement Cement grout Bentonite Other _____
 Grout Interval: From 4 ft. to 24 ft., From _____ ft. to _____ ft., From _____ ft. to _____ ft.

Nearest source of possible contamination:
 Septic Tank Lateral Lines Pit Privy Livestock Pens Insecticide Storage
 Sewer Lines Cess Pool Sewage Lagoon Fuel Storage Abandoned Water Well
 Watertight Sewer Lines Seepage Pit Feedyard Fertilizer Storage Oil Well/Gas Well
 Other (Specify) _____
 Direction from well? North Distance from well? 78 ft.

10 FROM	TO	LITHOLOGIC LOG	FROM	TO	LITHO. LOG (cont.) or PLUGGING INTERVALS
0	2	topsoil			
2	33	clay			
33	51	fine sand			
51	80	med. sand			

Notes:

11 CONTRACTOR'S OR LANDOWNER'S CERTIFICATION: This water well was constructed, reconstructed, or plugged under my jurisdiction and was completed on (no-day-year) 8/10/15 and this record is true to the best of my knowledge and belief. Kansas Water Well Contractor's License No. 611. This Water Well Record was completed on (no-day-year) 9/11/15 under the business name of Chase Drilling

INSTRUCTIONS: Send one copy to WATER WELL OWNER and retain one copy for your records. Submit fee of \$5.00 for each constructed well along with one (white) copy to Kansas Department of Health and Environment, Bureau of Water, Geology Section, 1000 SW Jackson St., Suite 420, Topeka, Kansas 66612-1367. Telephone (785) 296-3565. Visit us at <http://www.kdheks.gov/waterwell/index.html> KSA 82a-1212 Revised 9/10/2012