


WATER WELL RECORD Form WWC-5 KSA 82a-1212

1 LOCATION OF WATER WELL: Sedgwick	FRACTION NW 1/4 NE 1/4 SW 1/4	SECTION NUMBER 29	TOWNSHIP NUMBER T 29 S	RANGE NUMBER R 2E E/W
--	---	-----------------------------	----------------------------------	---------------------------------

Distance and direction from nearest town or city street address of well if located within city?
1641 N. Prairie Run Circle Mulvane, Kansas

2 WATER WELL OWNER: MEYERS, Nate & Destiny	Board of Agriculture, Division of Water Resource
RR#.ST. ADDRESS, BOX #: 1641 N. Prairie Run Circle	Application Number:
CITY, STATE: Mulvane, Kansas	ZIP CODE:

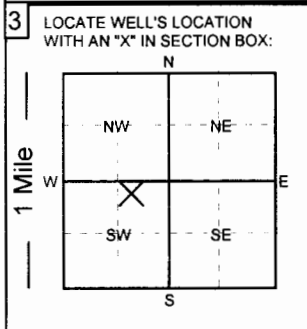

4 DEPTH OF COMPLETED WELL: 75 ft.	ELEVATION:
Depth of groundwater Encountered: _____ ft.	
WELL'S STATIC WATER LEVEL 40 FT. BELOW LAND SURFACE MEASURED ON 9/28/17	
Pump test data:	Well water was _____ ft. after _____ hours of pumping @ _____ gpm
Est. Yield: _____ gpm	Well water was _____ ft. after _____ hours of pumping @ _____ gpm
Bore Hole Diameter 12 in.	to 75 ft. and _____ in. to _____ ft.
WELL WATER TO BE USED AS:	
1. Domestic	3. Feedlot
5. Public water supply	7. <u>Lawn and garden only</u>
9. Dewatering	11. Injection well
2. Irrigation	4. Industrial
6. Oil field water supply	8. Air conditioning
10. Monitoring well	12. Other (Specify below)
Was a chemical/bacteriological sample submitted to Department? YES <u>NO</u> ; If yes, what mo/day/yr was sample submitted	
Was Water Well Disinfected? <u>YES</u> NO	

5 TYPE OF CASING USED:	CASING JOINTS: <u>Glued</u> Threaded
1. Steel	3. RPM (SR)
2. <u>PVC</u>	4. ABS
5. Wrought Iron	7. Fiberglass
6. Asbestos-Cement	8. Concrete tile
9. Other (Specify below)	SDR-26
Blank casing diameter 5 in.	to 56 ft., Dia. _____ in. to _____ ft., Dia. _____ in. to _____ ft.
Casing height above land surface: 12 in.,	Weight: 2.35 lbs. / ft. Wall thickness or gauge No. .214
TYPE OF SCREEN OR PERFORATION MATERIAL:	
1. Steel	3. Stainless Steel
5. Fiberglass	7. <u>PVC</u>
9. ABS	11. Other (specify)
2. Brass	4. Galvanized
6. Concrete Tile	8. RMP (SR)
10. Asbestos-Cement	12. None used (open hole)
SCREEN OR PERFORATION OPENINGS ARE:	
1. Continuous slot	3. Mill slot
5. Gauzed wrapped	7. Torch cut
9. Drilled holes	11. None (open hole)
2. Louvered shutter	4. Key punched
6. Wire wrapped	8. <u>Saw cut</u>
10. Other (specify)	
SCREEN - PERFORATION INTERVAL	
From 56 ft.	to 76 ft.,
From _____ ft.	to _____ ft.,
GRAVEL PACK INTERVALS:	
From 24 ft.	to 76 ft.,
From _____ ft.	to _____ ft.,

6 GROUT MATERIALS:	1. Neat cement	2. Cement Grout	3. Bentonite	Other bentonite hole plug
Grout Intervals: From 4 ft.	to 24 ft.,	From _____ ft.	to _____ ft.,	From _____ ft.
What is the nearest source of possible contamination:				
1. <u>Septic tank</u>	4. Lateral lines	7. Pit privy	10. Livestock pens	13. Insecticide storage
2. Sewer lines	5. Cess Pool	8. Sewage lagoon	11. Fuel storage	14. Abandon water well
3. <u>Watertight sewer line</u>	6. Seepage pit	9. Feed yard	12. Fertilizer storage	15. Oil well/Gas well
Direction from well? East				16. Other (specify below)
				How many feet? 10 ft. plus

From	To	LITHOLOGIC LOG	From	To	LITHOLOGIC LOG
0	3	topsoil			
3	48	clay and sand mix			
48	56	fine sand			
56	65	clay and shale			
65	75	medium sand			

7 Contractor's or Landowner's Certification: This water well was 1. <u>constructed</u> 2. reconstructed or 3. plugged under my jurisdiction and was completed on (mo/day/year) 9/28/17 and this record is true to the best of my knowledge and belief.	This water well record was completed on (mo/day/year) 10/4/17
Kansas Water Well Contractor's License No. 236	under the business name of Harp Well and Pump Service
	by (signature) Todd S. Harp