
				WWC-5	Div	ision of Water	•		IAS7		
				ge in Well Use		ources App. N		Well ID			
1 LOCATION OF WATER WELL:			Fraction				nge Number				
	: Sedgwic			SE 1/4 SE 1/4 SE 1/4		E ¼ 6 T 29 S R 2 ■ E □ W  reet or Rural Address where well is located (if unknown, distance and					
2 WELL Business:	OWNER:	Last Name: Sae	eed								
Address:	3008 No	rmandy Drive				irection from nearest town or intersection): If at owner's address, check here:					
Address:	0000110	mandy Brive	•		615 N. Ro	615 N. Rock Road, Derby					
City:	McKinne	V	State: TX	ZIP: 75070							
3 LOCAT		4 DEPTH	OF CON	MPLETED WELL: .	22 fi	5 Latitu	de: 37.5489	0	(decimal degrees)		
WITH "				Encountered: 1)1							
SECTIO				3) ft., or 4)							
	`			TER LEVEL:	Source for Latitude/Longitude:						
				e, measured on (mo-day-		.   GF	GPS (unit make/model:)				
above land surface, r				, measured on (mo-day-	yr)	1	(WAAS enabled? ☐ Yes ☐ No)				
,,,	Pump test data: Well water was  afterhours pumping					= zame our to,					
W	E	anti		vater was f							
SW	SE	after		s pumping	ann -						
				gnm	,		6 Elevation: 1288.69 ft. Ground Level TOC				
1	S	Bore Hole I	Diameter:	8in. to22	ft. and	Source	Source: Land Survey GPS Topographic Map				
1 n				in. to	ft.		☐ Other		• • • • • • • • • • • • • • • • • • • •		
		O BE USED									
1. Domestic:				ater Supply: well ID			Field Water Supply: 1				
☐ Housel☐ Lawn &				ng: how many wells? echarge: well ID			ole: well ID				
Livesto				g: well ID			sed Uncased Uncased crmal: how many bore				
2. Irrigati				al Remediation: well ID			sed Loop    Horizon				
3. Feedlo			Air Sparge				en Loop  Surface Di				
4. 🗌 Industr	ial		] Recovery	☐ Injection		13. 🔲 Oth	ner (specify):				
Was a cher	mical/bacte	riological san	nple subm	nitted to KDHE?	Yes No	If yes, date	sample was submitte	d:			
Water well	disinfected	? ☐ Yes ■	No			•	· •				
8 TYPE O	F CASING	G USED: S	teel PV	C  Other Diameter Neight	CASI	NG JOINTS:	☐ Glued ☐ Clamped	d □ Welde	d Threaded		
Casing diam	eter2	in. to	.20 ft.,	Diameter	in. to	ft., Diame	eter in. to	ft.			
Casing heigh	it above land	surface	5.28 in	n. Weight	lbs./ft.	Wall thicks	ness or gauge NoSch	4.0			
☐ Steel		R PERFORAT					(0 (0)				
☐ Brass		inless Steel Ivanized Steel			sed (open hole		er (Specify)		••••		
_		RATION OPE			sea (open non	=)					
	nuous Slot	Mill Slot			rch Cut 🗆 🗆	rilled Holes	☐ Other (Specify)				
☐ Louve	red Shutter	☐ Kev Puncl	ned □ W	ire Wrapped ☐ Say	w Cut □ N	Jone (Open Ho	ole)				
SCREEN-P	ERFORAT	ED INTERVA	ALS: Fron	n .20 ft. to .22	ft., From .	ft. to	ft., From	ft. to	ft.		
G	RAVEL PA	CK INTERV	ALS: Fron	n1.7 ft. to2.2.	ft., From .	ft. to	ft., From	ft. to	ft.		
9 GROUT	MATERI	AL: Neat of	ement [	Cement grout Be	ntonite 🔲 (	Other					
Grout Interv	als: From	ft. to	1./	ft., From	ft. to	ft., From .	ft. to	ft.			
		ole contaminati		□ n: n :	_	T: 1 D		. 1 . 0.			
☐ Septic ′			Lateral Line Cess Pool	es		Livestock Pen Fuel Storage		cide Storage oned Water			
	ght Sewer L		Seepage Pit			Fertilizer Stor		ll/Gas Well			
Other (	Specify) .Co	ontaminated.	site								
Direction fro	m well?			Distance from we	11?						
10 FROM	TO		ITHOLO		FROM	TO 1	LITHO. LOG (cont.) or	PLUGGIN	G INTERVALS		
	5	Silt, sandy (v									
5	18	Sand, f-c w/f									
18	22	Sand, vf-m,	silty, Gray	to Gray Brown							
					N		10.007.407.47				
					Notes: K	DHE Project #	U2-087-12717				
					-						
11 CONTRACTOR'S OR LANDOWNER'S CERTIFICATION: This water well was ■ constructed, □ reconstructed, or □ plugged											
under my i	risdiction	ond was compl	eted on (n	no-day-year) .4/27/20	21 and	this record is	true to the best of m	v knowled	ge and belief.		
Kansas Wa	ter Well Co	ntractor's Lice	ense No. 🌣	221 This Wa	ter Well Rec	ord was com	pleted on (mg-day-y	ear) .1/20/2	2022		
under the b	usiness nan	ne of .GeoCo	re, LLC		Si	gnature	ale fall				
				ch constructed well to: Kan							
				66612-1367. Mail one to V			e for your records. Teleph	one /85-296-	-5524.   <b>7/10/2015</b>		
Visit us at http	://www.kdhel	s.gov/waterwell/i	ndex.html		KSA 82a-12	14		Kevisea	//10/2015		

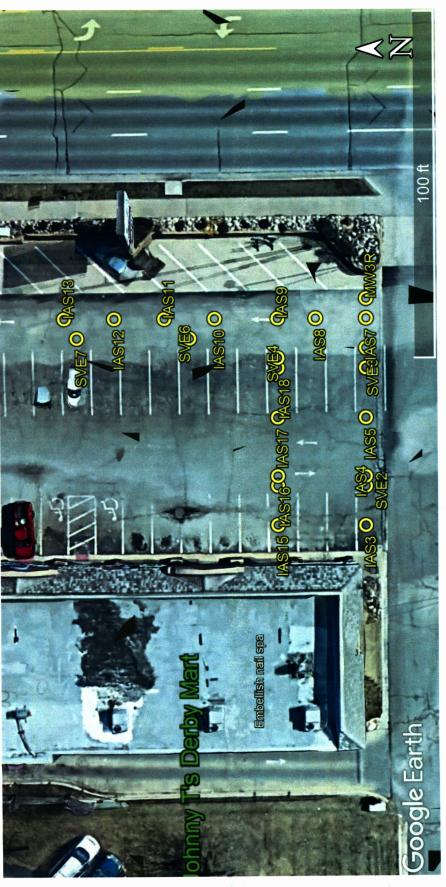

Project Site:

Johnny T's Derby Mart, 615 N. Rock Road, Derby

KDHE Project Code: U2-087-12717

## GPS Coordinates:

AS11: 37.54906, -97.24451	37.54910, -97.24451	AS13: 37.54914, -97.24451	AS15: 37.54897, -97.24472	AS16: 37.54897, -97.24467	AS17: 37.54897, -97.24461	AS18: 37.54897, -97.24456
IAS11:	IAS12:	IAS13:	IAS15:	IAS16:	IAS17:	IAS18:
37.54890, -97.24472	37.54890, -97.24467	37.54890, -97.24461	37.54890, -97.24456	37.54890, -97.24451	37.54894, -97.24451	37.54897, -97.24451
IAS3:	IAS4:	IAS5:	IAS6:	IAS7:	IAS8:	IAS9:

MW3R: 37.54890, -97.24449

IAS10: 37.54902, -97.24451

37.54890, -97.24468 37.54890, -97.24454 37.54897, -97.24455 37.54897, -97.24468 37.54904, -97.24453 37.54913, -97.24453

SVE2: SVE3:

SVE4: SVE5:

SVE6: SVE7: