


☒ Original Record ☐ Correction ☐ Change in Well Use

SVE7

Well ID

1 LOCATION OF WATER WELL: County: Sedgwick		Fraction NE¼SE¼SE¼SE¼	Section Number 6	Township Number T 29 S	Range Number R 2 E W					
2 WELL OWNER: Last Name: Saeed First: Mohammad Street or Rural Address where well is located (if unknown, distance and direction from nearest town or intersection): If at owner's address, check here: ☐ Business: Address: 3008 Normandy Drive City: McKinney State: TX ZIP: 75070 615 N. Rock Road, Derby										
3 LOCATE WELL WITH "X" IN SECTION BOX: N <table border="1" style="margin:auto; width:100px; height:100px;"> <tr><td>--NW--</td><td>--NE--</td></tr> <tr><td> </td><td> </td></tr> <tr><td>--SW--</td><td>--SE-- X</td></tr> </table>S W-----E ----- 1 mile	--NW--	--NE--			--SW--	--SE-- X	4 DEPTH OF COMPLETED WELL:10..... ft. Depth(s) Groundwater Encountered: 1) ft. 2) ft. 3) ft., or 4) ☐ Dry Well WELL'S STATIC WATER LEVEL: ft. ☐ below land surface, measured on (mo-day-yr) ☐ above land surface, measured on (mo-day-yr) Pump test data: Well water was ft. after hours pumping gpm Well water was ft. after hours pumping gpm Estimated Yield: gpm Bore Hole Diameter: 1½ in. to 10 ft. and in. to ft.	5 Latitude: 37.54913(decimal degrees) Longitude: -97.24453(decimal degrees) Horizontal Datum: ☐ WGS 84 ☒ NAD 83 ☐ NAD 27 Source for Latitude/Longitude: ☐ GPS (unit make/model:) (WAAS enabled? ☐ Yes ☐ No) ☒ Land Survey ☐ Topographic Map ☐ Online Mapper:		
--NW--	--NE--									
--SW--	--SE-- X									
7 WELL WATER TO BE USED AS: 1. Domestic: ☐ Household ☐ Lawn & Garden ☐ Livestock 2. Irrigation 3. Feedlot 4. Industrial 5. ☐ Public Water Supply: well ID 6. ☐ Dewatering: how many wells? 7. ☐ Aquifer Recharge: well ID 8. ☐ Monitoring: well ID 9. Environmental Remediation: well ID SVE7 ☐ Air Sparge ☒ Soil Vapor Extraction ☐ Recovery ☐ Injection 10. ☐ Oil Field Water Supply: lease 11. Test Hole: well ID ☐ Cased ☐ Uncased ☐ Geotechnical 12. Geothermal: how many bores? a) Closed Loop ☐ Horizontal ☐ Vertical b) Open Loop ☐ Surface Discharge ☐ Inj. of Water 13. ☐ Other (specify):		Was a chemical/bacteriological sample submitted to KDHE? ☐ Yes ☒ No If yes, date sample was submitted: Water well disinfected? ☐ Yes ☒ No								
8 TYPE OF CASING USED: ☐ Steel ☒ PVC ☐ Other CASING JOINTS: ☐ Glued ☐ Clamped ☐ Welded ☒ Threaded Casing diameter 4 in. to 5 ft., Diameter in. to ft., Diameter in. to ft. Casing height above land surface -7.32 in. Weight lbs./ft. Wall thickness or gauge No. Sch. 40 TYPE OF SCREEN OR PERFORATION MATERIAL: ☐ Steel ☐ Stainless Steel ☐ Fiberglass ☒ PVC ☐ Other (Specify) ☐ Brass ☐ Galvanized Steel ☐ Concrete tile ☐ None used (open hole)										
SCREEN OR PERFORATION OPENINGS ARE: ☐ Continuous Slot ☒ Mill Slot ☐ Gauze Wrapped ☐ Torch Cut ☐ Drilled Holes ☐ Other (Specify) ☐ Louvered Shutter ☐ Key Punched ☐ Wire Wrapped ☐ Saw Cut ☐ None (Open Hole)										
SCREEN-PERFORATED INTERVALS: From .5 ft. to 10 ft., From ft. to ft., From ft. to ft. GRAVEL PACK INTERVALS: From .4 ft. to 10 ft., From ft. to ft., From ft. to ft.										
9 GROUT MATERIAL: ☐ Neat cement ☐ Cement grout ☒ Bentonite ☐ Other Grout Intervals: From .3 ft. to .4 ft., From ft. to ft., From ft. to ft.										
Nearest source of possible contamination: ☐ Septic Tank ☐ Lateral Lines ☐ Pit Privy ☐ Livestock Pens ☐ Insecticide Storage ☐ Sewer Lines ☐ Cess Pool ☐ Sewage Lagoon ☐ Fuel Storage ☐ Abandoned Water Well ☐ Watertight Sewer Lines ☐ Seepage Pit ☐ Feedyard ☐ Fertilizer Storage ☐ Oil Well/Gas Well ☒ Other (Specify) Contaminated site										
Direction from well? Distance from well? ft.										
10 FROM	TO	LITHOLOGIC LOG	FROM	TO	LITHO. LOG (cont.) or PLUGGING INTERVALS					
0	0.5	Asphalt								
0.5	2.5	Clay, silty, Brown								
2.5	8	Sand, vf-c, Brown to Gray Brown								
8	10	Sand, vf-c, sl. silty, Dark Gray Brown								
			Notes: KDHE Project #U2-087-12717							
11 CONTRACTOR'S OR LANDOWNER'S CERTIFICATION: This water well was ☒ constructed, ☐ reconstructed, or ☐ plugged under my jurisdiction and was completed on (mo-day-year) 4/28/2021 and this record is true to the best of my knowledge and belief. Kansas Water Well Contractor's License No. 527 This Water Well Record was completed on (mo-day year) 1/20/2022 under the business name of GeoCore LLC Signature Dale Wells										
Mail 1 white copy along with a fee of \$5.00 for each constructed well to: Kansas Department of Health and Environment, Bureau of Water, GWTS Section, 1000 SW Jackson St., Suite 420, Topeka, Kansas 66612-1367. Mail one to Water Well Owner and retain one for your records. Telephone 785-296-5524. Visit us at http://www.kdheks.gov/waterwell/index.html KSA 82a-1212 Revised 7/10/2015										

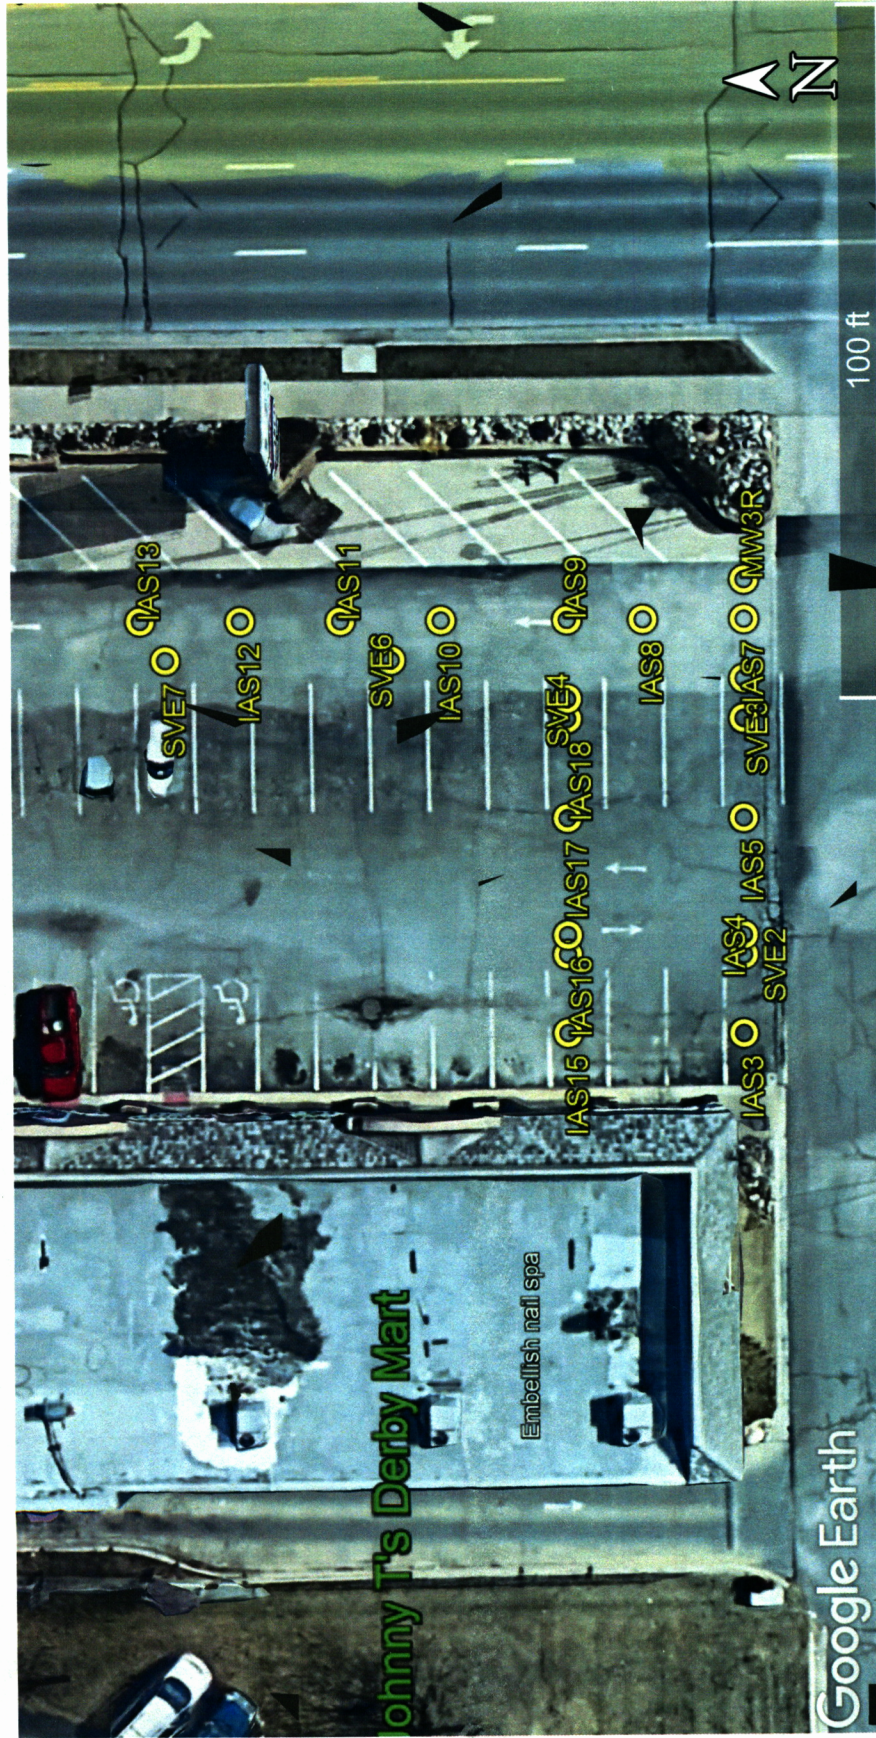

Project Site:

Johnny T's Derby Mart, 615 N. Rock Road, Derby

KDHE Project Code: U2-087-12717

GPS Coordinates:

IAS3: 37.54890, -97.24472
 IAS4: 37.54890, -97.24467
 IAS5: 37.54890, -97.24461
 IAS6: 37.54890, -97.24456
 IAS7: 37.54890, -97.24451
 IAS8: 37.54894, -97.24451
 IAS9: 37.54897, -97.24451
 IAS10: 37.54902, -97.24451

IAS11: 37.54906, -97.24451
 IAS12: 37.54910, -97.24451
 IAS13: 37.54914, -97.24451
 IAS15: 37.54897, -97.24472
 IAS16: 37.54897, -97.24467
 IAS17: 37.54897, -97.24461
 IAS18: 37.54897, -97.24456
 MW3R: 37.54890, -97.24449

SVE2: 37.54890, -97.24468
 SVE3: 37.54890, -97.24454
 SVE4: 37.54897, -97.24455
 SVE5: 37.54897, -97.24468
 SVE6: 37.54904, -97.24453
 SVE7: 37.54913, -97.24453