


☐ Original Record ☐ Correction ☐ Change in Well Use

Well ID

SVF5

[illegible]

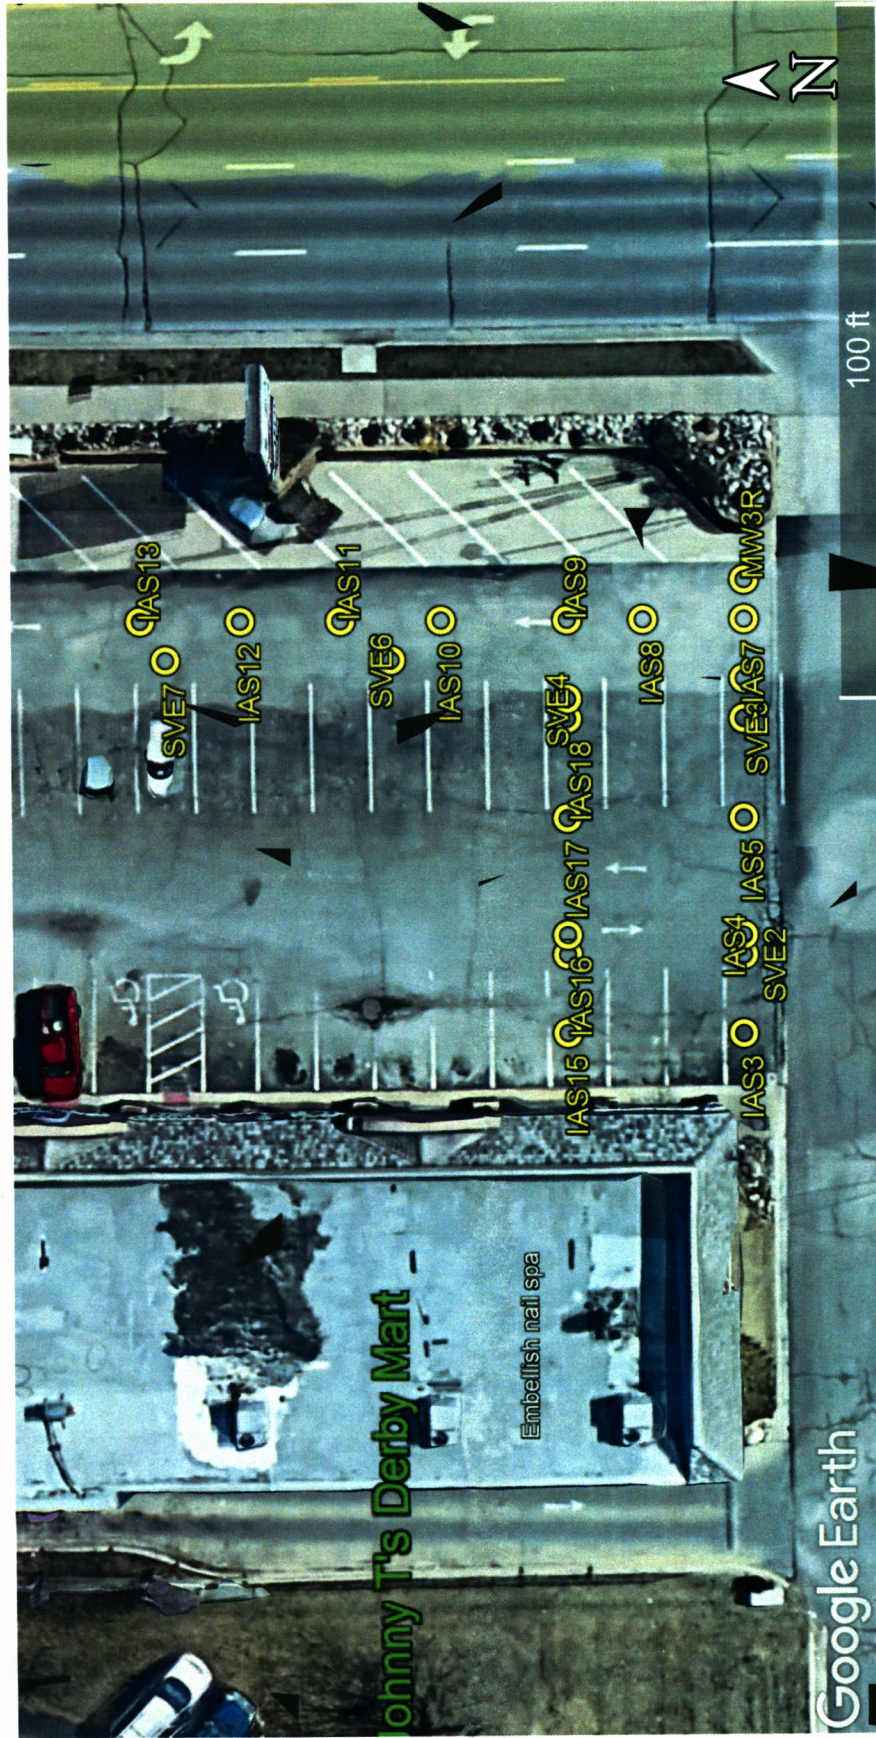

Project Site:

Johnny T's Derby Mart, 615 N. Rock Road, Derby

KDHE Project Code: U2-087-12717

GPS Coordinates:

IAS3: 37.54890, -97.24472
IAS4: 37.54890, -97.24467
IAS5: 37.54890, -97.24461
IAS6: 37.54890, -97.24456
IAS7: 37.54890, -97.24451
IAS8: 37.54894, -97.24451
IAS9: 37.54897, -97.24451
IAS10: 37.54902, -97.24451

IAS11: 37.54906, -97.24451
IAS12: 37.54910, -97.24451
IAS13: 37.54914, -97.24451
IAS15: 37.54897, -97.24472
IAS16: 37.54897, -97.24467
IAS17: 37.54897, -97.24461
IAS18: 37.54897, -97.24456
MW3R: 37.54890, -97.24449

SVE2: 37.54890, -97.24468
SVE3: 37.54890, -97.24454
SVE4: 37.54897, -97.24455
SVE5: 37.54897, -97.24468
SVE6: 37.54904, -97.24453
SVE7: 37.54913, -97.24453