


WATER WELL RECORD Form WWC-5

Original Record Correction Change in Well Use

Division of Water Resources App. No. Well ID

1 LOCATION OF WATER WELL: County: SEDGWICK Fraction NE 1/4 NW 1/4 SE 1/4 SE 1/4 Section Number 29 Township Number T 29 S Range Number R 2 E W

2 WELL OWNER: Last Name: Business: JCBB INVESTMENT PROPERTIES LLC Address: P.O. BOX 780153 City: WICHITA State: KS ZIP: 67278 Street or Rural Address where well is located: 1509 N. EMERALD VALLEY CIR. MULVANE, KS 67110

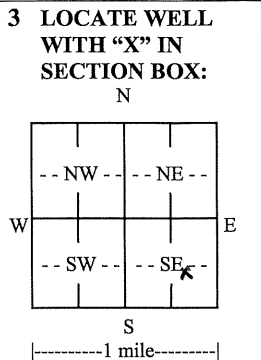

3 LOCATE WELL WITH 'X' IN SECTION BOX: N W E S
4 DEPTH OF COMPLETED WELL: 85 ft. Depth(s) Groundwater Encountered: 1) 85 ft. 2) 85 ft. 3) 85 ft. or 4) Dry Well
WELL'S STATIC WATER LEVEL: 33 ft. below land surface, measured on (mo-day-yr) 12-8-2023
Pump test data: Well water was 12 ft. after 12 hours pumping 85 gpm
Estimated Yield: 85 gpm
Bore Hole Diameter: 12 in. to 85 ft. and 85 in. to 85 ft.

5 Latitude: 37.49344 (decimal degrees) Longitude: -97.22954 (decimal degrees) Horizontal Datum: WGS 84 NAD 83 NAD 27 Source for Latitude/Longitude: GPS (unit make/model: I-PHONE) (WAAS enabled? Yes No) Land Survey Topographic Map Online Mapper:
6 Elevation: ft. Ground Level Topographic Map Source: Land Survey GPS Topographic Map Other

7 WELL WATER TO BE USED AS: 1. Domestic: Househoid Lawn & Garden Livestock Irrigation Feedlot Industrial 2. Public Water Supply: well ID 3. Dewatering: how many wells? 4. Aquifer Recharge: well ID 5. Monitoring: well ID 6. Environmental Remediation: well ID Air Sparge Soil Vapor Extraction Recovery Injection 7. Oil Field Water Supply: lease 8. Test Hole: well ID Cased Uncased Geotechnical 9. Geothermal: how many bores? a) Closed Loop Horizontal Vertical b) Open Loop Surface Discharge Inj. of Water 10. Other (specify):

Was a chemical/bacteriological sample submitted to KDHE? Yes No If yes, date sample was submitted: Water well disinfected? Yes No

8 TYPE OF CASING USED: Steel PVC Other CASING JOINTS: Glued Clamped Welded Threaded Casing diameter 5 in. to 85 ft., Diameter 12 in. to 85 ft., Diameter 12 in. to 85 ft. Casing height above land surface 12 in. Weight 2.35 lbs./ft. Wall thickness or gauge No. SDR26 TYPE OF SCREEN OR PERFORATION MATERIAL: Steel Stainless Steel Fiberglass PVC Other (Specify) Brass Galvanized Steel Concrete tile None used (open hole) SCREEN OR PERFORATION OPENINGS ARE: Continuous Slot Mill Slot Gauze Wrapped Torch Cut Drilled Holes Other (Specify) Louvered Shutter Key Punched Wire Wrapped Saw Cut None (Open Hole) SCREEN-PERFORATED INTERVALS: From 45 ft. to 85 ft., From ft. to ft., From ft. to ft. GRAVEL PACK INTERVALS: From 24 ft. to 85 ft., From ft. to ft., From ft. to ft.

9 GROUT MATERIAL: Neat cement Cement grout Bentonite Other Grout Intervals: From 4 ft. to 24 ft., From ft. to ft., From ft. to ft. Nearest source of possible contamination: Septic Tank Lateral Lines Pit Privy Livestock Pens Insecticide Storage Sewer Lines Cess Pool Sewage Lagoon Fuel Storage Abandoned Water Well Watertight Sewer Lines Seepage Pit Feedyard Fertilizer Storage Oil Well/Gas Well Other (Specify) Direction from well? NORTH Distance from well? 12+ ft.

Table with 6 columns: 10 FROM, TO, LITHOLOGIC LOG, FROM, TO, LITHO. LOG (cont.) or PLUGGING INTERVALS. Rows: 0-3 TOP SOIL, 3-25 BROWN CLAY, 25-30 FINE SAND, 30-45 GREEN SHALE, 45-81 GRAY SHALE, 81-85 LIMESTONE. Includes a Notes section.

11 CONTRACTOR'S OR LANDOWNER'S CERTIFICATION: This water well was constructed, reconstructed, or plugged under my jurisdiction and was completed on (mo-day-year) 12-8-2023 and this record is true to the best of my knowledge and belief. Kansas Water Well Contractor's License No. 236. This Water Well Record was completed on (mo-day-year) 12-9-2023 under the business name of HARP WELL AND PUMP SERVICE INC. Signature T.ODD S.HARP