USE TYPEWRITER OR BALL POINT PEN-PRESS FIRMLY, PRINT CLEARLY.

WATER WELL RECORD
KSA 82a-1201-1215

Kansas Department of Health and Environment-Division of Environment
(Water well Contractors)
Topeka, Kansas 66620

1. Location of well: County: Sedgwick | Fraction: NW 1/4 SW 1/4 SE 1/4 | Section number: 6 | Township number: T 29 S | Range number: R 2 (E) W

2. Distance and direction from nearest town or city:
Street address of well location if in city: 624 Briarwood Derby Ks.

3. Owner of well: Fred Bartel
R.R. or street: 624 Briarwood
City, state, zip code: Derby, Ks 67037

4. Locate with "X" in section below:

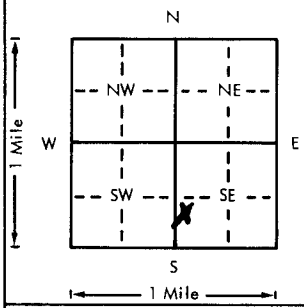

Sketch map:

6. Bore hole dia. 11 in. Completion date 2/13/79
Well depth 76 ft.

7. __ Cable tool ✓ Rotary __ Driven __ Dug
__ Hollow rod __ Jetted __ Bored __ Reverse rotary

8. Use: __ Domestic __ Public supply __ Industry
__ Irrigation __ Air conditioning __ Stock
✓ Lawn __ Oil field water Other

9. Casing: Material Steel Weight Above or below
Threaded ___ Welded X Surface 12 in.
RMP X PVC ___ Weight 1.50 lbs./ft.
Dia. 5 in. to 76 ft. depth Wall Thickness: inches or
Dia. ___ in. to ___ ft. depth gage No. 1200

10. Screen: Manufacturer's name Sunflower
Type 200 Dia. 5 in
Slot/gauze 116 Length 40 ft
Set between 36 ft. and 76 ft.
___ ft. and ___ ft.
Gravel pack? Yes Size range of material 3/8

11. Static water level:
30 ft. below land surface Date 2/13/79 mo./day/yr.

12. Pumping level below land surfaces:
35 ft. after 1/2 hrs. pumping 12 g.p.m.
___ ft. after ___ hrs. pumping ___ g.p.m.
Estimated maximum yield 12-25 g.p.m.

13. Water sample submitted: mo./day/yr.
___ Yes X No Date ___

14. Well head completion:
___ Pitless adapter 12 inches above grade

15. Well grouted? Yes
With: ___ Neat cement ___ Bentonite X Concrete
Depth: From 0 ft. to 10 ft.

16. Nearest source of possible contamination:
ft. ___ Direction ___ Type ___
Well disinfected upon completion? X Yes ___ No

17. Pump: X Not installed
Manufacturer's name ___
Model number ___ HP ___ Volts ___
Length of drop pipe ___ ft. capacity ___ g.p.m.
Type:
___ Submersible ___ Turbine
___ Jet ___ Reciprocating
___ Centrifugal ___ Other

5. Type and color of material

From	To
Red clay	0	16
fine sand	16	34
Brown rockish loam	34	53
Charcoal shale	53	76

(Use a second sheet if needed)

18. Elevation:
Topography:
X Hill
___ Slope
___ Upland
___ Valley

19. Remarks: ~~Customer to furnish 4'x4'x4" slab around well at grade per State Regulations~~
~~Signed X~~

20. Water well contractor's certification:
This well was drilled under my jurisdiction and this report is true to the best of my knowledge and belief.
Business name Mundell Drilling License No. 318
Address RR 1 Colwich Ks
Signed [signature] Date 2/19/79
Authorized representative

29 — 2 (E) 6 — NWSWSE
T — R — Sec — 1/4 1/4 1/4

Forward the white, blue and pink copies to the Department of Health and Environment

Form WWC-5

MI-1023