USE TYPEWRITER OR BALL POINT PEN-PRESS FIRMLY, PRINT CLEARLY.

WATER WELL RECORD
KSA 82a-1201-1215

Kansas Department of Health and Environment-Division of Environment
(Water well Contractors)
Topeka, Kansas 66620

1. Location of well:	County: Sedgwick	Fraction: 1/4 SW 1/4 SW 1/4	Section number: 7	Township number: T 29 S	Range number: R 2 (E) W

2. Distance and direction from nearest town or city: Farborough Estates
Street address of well location if in city:

3. Owner of well: Confederated Builders
R.R. or street: Box 572
City, state, zip code: Derby, Kansas

4. Locate with "X" in section below:

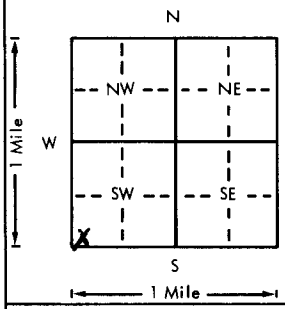

Sketch map: approximately 1/2 South of Derby 200 yards East of Woodlawn. ~~Wood~~ Derby, Kansas

6. Bore hole dia. 11 in. Completion date 6-14-76
Well depth 88 ft.

7. __ Cable tool ✓ Rotary __ Driven __ Dug
__ Hollow rod __ Jetted __ Bored __ Reverse rotary

8. Use: ✓ Domestic __ Public supply __ Industry
__ Irrigation __ Air conditioning __ Stock
__ Lawn __ Oil field water __ Other

9. Casing: Material STYRENE Height: (Above) or below
Threaded __ Welded GL Surface 12 in.
RMP ✓ PVC __ Weight __ lbs./ft.
Dia. 5 in. to 88 ft. depth Wall Thickness: inches or
Dia. __ in. to __ ft. depth gage No. .200

5. Type and color of material	From	To
Dirt	0	3
Clay	3	35
Fine Sand	35	45
Shale	45	88

(Use a second sheet if needed)

10. Screen: Manufacturer's name SUNFLOWER PLASTIC
Type STYRENE Dia. 5"
(Slot) gauze .06 Length 48 ft
Set between 40 ft. and 88 ft.
__ ft. and __ ft.
Gravel pack? YES Size range of material 1/4-1/8"

11. Static water level: mo./day/yr.
40 ft. below land surface Date 6-14-76

12. Pumping level below land surfaces:
__ ft. after __ hrs. pumping __ g.p.m.
__ ft. after __ hrs. pumping __ g.p.m.
Estimated maximum yield __ g.p.m.

13. Water sample submitted: mo./day/yr.
__ Yes __ No Date

14. Well head completion: Capped
__ Pitless adapter 12 Inches above grade

15. Well grouted? YES
With: __ Neat cement __ Bentonite ✓ Concrete
Depth: From 40" to 14 ft.

16. Nearest source of possible contamination: None
ft. __ Direction __ Type
Well disinfected upon completion? ✓ Yes __ No

17. Pump: ✓ Not installed
Manufacturer's name
Model number HP Volts
Length of drop pipe ft. capacity g.p.m.
Type:
__ Submersible __ Turbine
__ Jet __ Reciprocating
__ Centrifugal __ Other

T 29 R 2 (E) W Sec 7 SW SW SW

18. Elevation:

Topography:
__ Hill
✓ Slope
__ Upland
__ Valley

19. Remarks: Septic Tank not installed when the well was drilled. No apparent source for contamination.

20. Water well contractor's certification:
This well was drilled under my jurisdiction and this report is true to the best of my knowledge and belief.
Business name HARP WELL & PUMP 236 License No.
Address WICHITA, KANSAS
Signed M. Arnold Date 8-25-76
Authorized representative

Forward the white, blue and pink copies to the Department of Health and Environment

Form WWC-5

MI-1023