USE TYPEWRITER OR BALL POINT PEN-PRESS FIRMLY, PRINT CLEARLY.

WATER WELL RECORD
KSA 82a-1201-1215

Kansas Department of Health and Environment-Division of Environment
(Water well Contractors)
Topeka, Kansas 66620

1. Location of well:	County	Fraction	Section number	Township number	Range number
	SEDGWICK	1/4NW 1/4NE 1/4	12	T 29 S	R 2E E/W

2. Distance and direction from nearest town or city: 15511 E.79th So. Derby, Kansas
Street address of well location if in city:

3. Owner of well: The Warren Company
R.R. or street: 637 No. Baltimore
City, state, zip code: Derby, Kansas

4. Locate with "X" in section below:

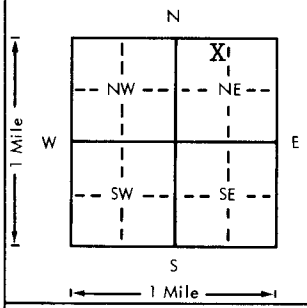

Sketch map:

6. Bore hole dia. 11 in. Completion date
Well depth 95 ft. 4-21-78

7. __ Cable tool X Rotary __ Driven __ Dug
__ Hollow rod __ Jetted __ Bored __ Reverse rotary

8. Use: X Domestic __ Public supply __ Industry
__ Irrigation __ Air conditioning __ Stock
__ Lawn __ Oil field water __ Other

9. Casing: Material styrene Height: Above or below
Threaded __ Welded gl Surface 12 in.
RMP X PVC Weight lbs./ft.
Dia. 5 in. to 95 ft. depth Wall Thickness: inches or
Dia. __ in. to __ ft. depth gage No. 200

5. Type and color of material	From	To
Topsoil	0	3
Clay	3	20
Gray Shale	20	95

(Use a second sheet if needed)

10. Screen: Manufacturer's name Sunflower Plastic
Type styrene Dia. 5"
Slot/~~Bore~~ .06 Length 75'
Set between 20 ft. and 95 ft.
ft. and ft.
Gravel pack? yes Size range of material ¼-1/8"

11. Static water level: mo./day/yr.
15 ft. below land surface Date 4-21-78

12. Pumping level below land surfaces:
ft. after hrs. pumping g.p.m.
ft. after hrs. pumping g.p.m.
Estimated maximum yield g.p.m.

13. Water sample submitted: mo./day/yr.
__ Yes __ No Date

14. Well head completion: capped
__ Pitless adapter 12 inches above grade

15. Well grouted? yes 1-2 Fine Sand Mix
With: __ Neat cement __ Bentonite X Concrete
Depth: From 40" ft. to 14 ft.

16. Nearest source of possible contamination:
ft. 50 Direction S.W. Type septic tank
Well disinfected upon completion? X Yes No

17. Pump: X Not installed
Manufacturer's name
Model number HP Volts
Length of drop pipe ft. capacity g.p.m.
Type:
__ Submersible __ Turbine
__ Jet __ Reciprocating
__ Centrifugal __ Other

T 29 R 2 E/W Sec 12 1/4 1/4 1/4 NW NE

18. Elevation:

Topography:
__ Hill
__ Slope
__ Upland
__ Valley

19. Remarks: Flat Ground

20. Water well contractor's certification:
This well was drilled under my jurisdiction and this report is true to the best of my knowledge and belief.
Harp Well & Pump 236
Business name License No.
Address Wichita, Kansas 67209
Signed M. Arnold Date 6-2-78
Authorized representative

Forward the white, blue and pink copies to the Department of Health and Environment

Form WWC-5

MI-1023