USE TYPEWRITER OR BALL POINT PEN-PRESS FIRMLY, PRINT CLEARLY.

WATER WELL RECORD
KSA 82a-1201-1215

Kansas Department of Health and Environment-Division of Environment
(Water well Cantractors)
Topeka, Kansas 66620

1. Location of well:	County: SEDGWICK	Fraction: NW 1/4 SW 1/4 1/4	Section number: 18	Township number: 29 T S	Range number: 2E R E/W

2. Distance and direction from nearest town or city:
Street address of well location if in city: #7 Krista Derby, Kansas

3. Owner of well: H & G Construction
R.R. or street: 9240 South Woodlawn
City, state, zip code: Derby, Kansas

4. Locate with "X" in section below: Sketch map:

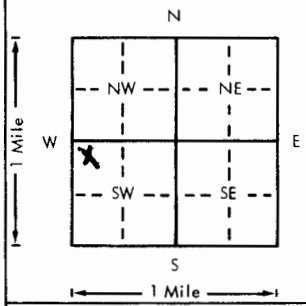

6. Bore hole dia 11 in. Completion date
Well depth 75 ft. 2-16-78

7. __ Cable tool X Rotary __ Driven __ Dug
__ Hollow rod __ Jetted __ Bored __ Reverse rotary

8. Use: X Domestic __ Public supply __ Industry
__ Irrigation __ Air conditioning __ Stock
__ Lawn __ Oil field water __ Other

9. Casing: Material styrene Height: Above or below ////
Threaded __ Welded gl Surface 12 in.
RMP X PVC __ Weight __ lbs./ft.
Dia. 5 in. to 75 ft. depth Wall Thickness: inches or
Dia. __ in. to __ ft. depth gage No. .200

5. Type and color of material	From	To
Topsoil	0	3
Clay	3	48
Fine Sand	48	55
Grey Shale	55	75
(Use a second sheet if needed)		

10. Screen: Manufacturer's name Sunflower Plastic
Type styrene Dia. 5"
Slot/~~gauze~~ .06 Length 25'
Set between 50 ft. and 75 ft.
ft. and ft.
Gravel pack? yes Size range of material ¼-1/8"

11. Static water level: mo./day/yr.
40 ft. below land surface Date 2-16-78

12. Pumping level below land surfaces:
ft. after hrs. pumping g.p.m.
ft. after hrs. pumping g.p.m.
Estimated maximum yield g.p.m.

13. Water sample submitted: mo./day/yr.
__ Yes __ No Date

14. Well head completion:
X Pitless adapter 12 Inches above grade

15. Well grouted? yes 1-2 fine sand mix
With: __ Neat cement __ Bentonite X Concrete
Depth: From 40" ft. to 14 ft.

16. Nearest source of possible contamination: NONE
ft. Direction X Type
Well disinfected upon completion? __ Yes __ No

17. Pump: Not installed
Manufacturer's name Sta-Rite
Model number 20P4D02 HP 3/4 Volts 230
Length of drop pipe 60 ft. capacity 20 g.p.m.
Type:
X Submersible __ Turbine
__ Jet __ Reciprocating
__ Centrifugal __ Other

T 29 R 2 E W Sec 18 1/4 1/4 1/4 NW SW

18. Elevation:
Topography:
__ Hill
__ Slope
__ Upland
__ Valley

19. Remarks:
Flat Ground
Septic system not installed at this time.
No apparent source for contamination.

20. Water well contractor's certification:
This well was drilled under my jurisdiction and this report is true to the best of my knowledge and belief.
Business name Harp Well & Pump License No. 236
Address Wichita, Kansas
Signed M. Arnold (Authorized representative) Date 6-6-78

Forward the white, blue and pink copies to the Department of Heolth and Environment

Form WWC-5

MI-1023