USE TYPEWRITER OR BALL POINT PEN-PRESS FIRMLY, PRINT CLEARLY.

T R EW sec 1/4 1/4 1/4 No.

WATER WELL RECORD
KSA 82a-1201-1215

Kansas State Dept. Of Health
(Water Well Contractors)
Forbes-Bldg. 740
Topeka, Kansas 66620

| 1 Location of well: | County | Township name | Fraction | Section number | Town number | Range number |
|---|---|---|---|---|---|---|
| | Sedgwick | Rockford | SW¼ NW¼ | 27 | 29S | 2E |

Distance and direction from nearest town or city: 1½ E. of Webb Rd.
Street address of well location if in city: on 106th St.So. Wichita, Kansas

3 Owner of well: J.C. Cockrell
Address: 3006 South Volutsia Wichita, Kansas

Locate with "X" in section below:

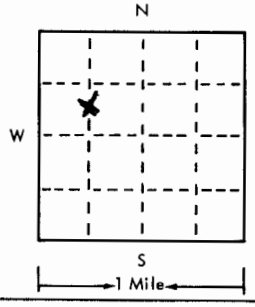


Sketch map:

4 Well depth: 73 ft. Date of completion 6-28-75
Well diameter 11 in.

5 ☐ Cable tool ☒ Rotary ☐ Driven ☐ Dug ☐ Hollow rod ☐ Jetted ☐ Bored ☐ Reverse rotary

6 Use: ☒ Domestic ☐ Public supply ☐ Industry ☐ Irrigation ☐ Air conditioning ☐ Commercial ☐ Test well ☐ _____

7 Casing: Material styrene Height: above/below ///
Threaded ☐ Welded ☐ Surface 12 in.
Diam. 5 in. to 73 ft. depth Weight _____ lbs./ft.
Drive shoe? ☐ Yes ☐ No
_____ in. to _____ ft. depth

| 2 Type and color of material | From | To |
|---|---|---|
| Dirt and Sandy top Soil | 0 | 2 |
| Sandy Clay | 2 | 30 |
| Fine Sand and Clay | 30 | 36 |
| Medium Fine Sand | 36 | 48 |
| Soft Shale | 48 | 73 |
| | | |
| | | |
| | | |
| | | |
| | | |
| | | |
| | | |
| | | |
| | | |
| (use a second sheet if needed) | | |

8 Screen:
Manufacturer Sunflower Plastic
Type styrene Dia. 5"
Slot/gauze .005 Length 33'
Set between 40 ft. and 73 ft.
Fittings:
Gravel pack ☒ Yes ☐ No Size range of material ¼-1/8"

9 Static water level:
20 ft. below land surface Date 6-28-75

10 Pumping level below land surfaces:
_____ ft. after _____ hrs. pumping _____ g.p.m.
_____ ft. after _____ hrs. pumping _____ g.p.m.
Estimated maximum yield _____ g.p.m.

11 Water sample submitted:
☐ Yes ☐ No Date _____

12 Well head completion: capped
☐ Pitless adapter 12 ☒ inches above grade

13 Well grouted? ☒ Yes ☐ No
☒ Neat cement ☐ Bentonite ☐ _____
Depth: From 0 ft. to 11 ft.

14 Nearest source of possible contamination: Septic
ft. 70 Direction SE Type Tank
Well disinfected upon completion? ☒ Yes ☐ No

15 Pump: ☒ Not installed
Manufacturer's name _____
Model number _____ HP _____ Volts _____
Length of drop pipe _____ ft. capacity _____ g.m.p.
Type:
☐ Submersible ☐ Turbine
☐ Jet ☐ Reciprocating
☐ Certrifugal ☐ Other

16 Remarks: elevation
Flat Ground

Topography:
☐ Hill
☐ Slope
☐ Upland
☐ Valley

17 Water well contractor's certification:
This well was drilled under my jurisdiction and this report is true to the best of my knowledge and belief.
Harp Well & Pump 236
Business name License No.
Address Wichita, Kansas 67209
Signed M Arnell Date 6-30-75
Authorized representative

Forward the white, blue and pink copies to the Kansas State Dept. Of Health.

Form WWC-5

677-H