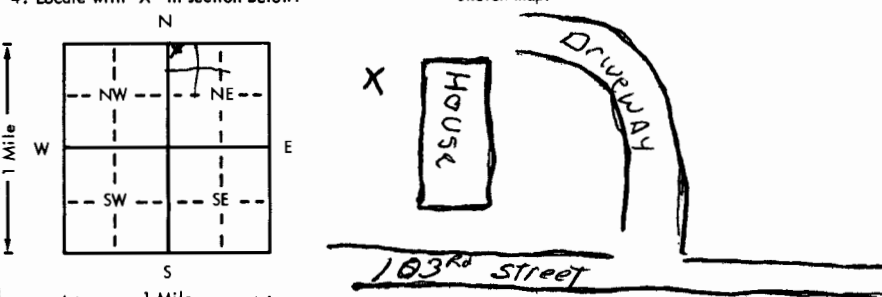


USE TYPEWRITER OR BALL
POINT PEN—PRESS FIRMLY,
PRINT CLEARLY.

WATER WELL RECORD
KSA 82a-1201-1215

Kansas Department of Health and
Environment—Division of Environment
(Water well Contractors)
Topeka, Kansas 66620

1. Location of well:	County <u>Sedgwick</u>	Fraction <u>NW 1/4 NW 1/4 NE 1/4</u>	Section number <u>30</u>	Township number <u>T 29 S</u>	Range number <u>R 2 E E/W</u>												
2. Distance and direction from nearest town or city: <u>and 1/2 mile East of Derby, Kans.</u>			3. Owner of well: <u>ROY THOMPSON</u> R.R. or street: <u>7117 E. 103rd S.</u> City, state, zip code: <u>McLANE, KS.</u>														
4. Locate with "X" in section below: 			6. Bore hole dia. <u>11</u> in. Completion date <u>7-1-77</u> Well depth <u>40</u> ft.														
5. Type and color of material			7. ☐ Cable tool ☐ Rotary ☐ Driven ☐ Dug ☐ Hollow rod ☐ Jetted ☐ Bored ☐ Reverse rotary														
<table border="1"><thead><tr><th></th><th>From</th><th>To</th></tr></thead><tbody><tr><td><u>Topsoil</u></td><td><u>0</u></td><td><u>20</u></td></tr><tr><td><u>Sand - fine</u></td><td><u>21</u></td><td><u>30</u></td></tr><tr><td><u>Sand - coarse</u></td><td><u>31</u></td><td><u>40</u></td></tr></tbody></table>				From	To	<u>Topsoil</u>	<u>0</u>	<u>20</u>	<u>Sand - fine</u>	<u>21</u>	<u>30</u>	<u>Sand - coarse</u>	<u>31</u>	<u>40</u>	8. Use: ☐ Domestic ☐ Public supply ☐ Industry ☐ Irrigation ☐ Air conditioning ☐ Stock ☒ Lawn ☐ Oil field water ☐ Other		
	From	To															
<u>Topsoil</u>	<u>0</u>	<u>20</u>															
<u>Sand - fine</u>	<u>21</u>	<u>30</u>															
<u>Sand - coarse</u>	<u>31</u>	<u>40</u>															
			9. Casing: Material <u>STEEL</u> Height: <u>(Above)</u> or below Threaded ☐ Welded ☒ Surface <u>12</u> in. RMP ☐ PVC ☐ Weight <u>1.5</u> lbs./ft. Dia. <u>5</u> in. to <u>40</u> ft. depth Wall Thickness: inches or Dia. <u>5</u> in. to <u>40</u> ft. depth gage No. <u>200</u>														
			10. Screen: Manufacturer's name <u>J&L</u> Type <u>200</u> Dia. <u>5"</u> Slot/gauze <u>.065</u> Length <u>10'</u> Set between <u>30'</u> ft. and <u>40'</u> ft. Gravel pack? <u>YES</u> Size range of material <u>8-30</u> ft.														
			11. Static water level: <u>21</u> ft. below land surface Date <u>7-1-77</u> mo./day/yr.														
			12. Pumping level below land surfaces: <u>22</u> ft. after <u>1</u> hrs. pumping <u>10</u> g.p.m. ft. after <u> </u> hrs. pumping <u> </u> g.p.m. Estimated maximum yield <u>25-30</u> g.p.m.														
			13. Water sample submitted: <u> </u> mo./day/yr. Yes ☒ No ☐ Date <u> </u>														
			14. Well head completion: <u> </u> Pitless adapter <u>12</u> inches above grade														
			15. Well grouted? <u>YES</u> With: <u> </u> Neat cement <u>Bentonite</u> Concrete Depth: From <u>0</u> ft. to <u>10</u> ft.														
			16. Nearest source of possible contamination: ft. <u>60</u> Direction <u>South</u> Type <u>Serbia</u> Well disinfected upon completion? <u>YES</u> Yes ☒ No ☐														
			17. Pump: <u>X</u> Not installed Manufacturer's name <u> </u> Model number <u> </u> HP <u> </u> Volts <u> </u> Length of drop pipe <u> </u> ft. capacity <u> </u> g.p.m. Type: ☐ Submersible ☐ Turbine ☐ Jet ☐ Reciprocating ☐ Centrifugal ☐ Other														
18. Elevation: Topography: ☐ Hill ☐ Slope ☐ Upland ☒ Valley			19. Remarks: <u>Did not find good gravel</u> <u>Well bugged some fine</u> <u>Sand.</u>														
			20. Water well contractor's certification: This well was drilled under my jurisdiction and this report is true to the best of my knowledge and belief. Business name <u>21st Electric Co.</u> License No. <u>29</u> Address <u>512 W. 21st St.</u> Signed <u>James R. Kins</u> Date <u>7-27-77</u> Authorized representative														

Forward the white, blue and pink copies to the Department of Health and Environment

Form WWC-5