USE TYPEWRITER OR BALL POINT PEN-PRESS FIRMLY, PRINT CLEARLY.

WATER WELL RECORD
KSA 82a-1201-1215

Kansas Department of Health and Environment-Division of Environment
(Water well Contractors)
Topeka, Kansas 66620

1. Location of well:	County	Fraction	Section number	Township number	Range number
	SEDGWICK	1/4 SW 1/4 SE 1/4	32	T 29 S	R 2E E/W

2. Distance and direction from nearest town or city: 3/4 S.E. of Rock Rd. on K-15, on the N. side of the road.
Street address of well location if in city:

3. Owner of well: Darryl Starbird
R.R. or street: 504 S.E. Lewis Blvd.
City, state, zip code: Mulvane, Kansas

4. Locate with "X" in section below:

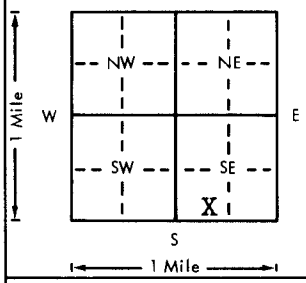

Sketch map: Mulvane, Kansas

6. Bore hole dia. 11 in. Completion date
Well depth 60 ft. 6-5-78

7. __ Cable tool X Rotary __ Driven __ Dug
__ Hollow rod __ Jetted __ Bored __ Reverse rotary

8. Use: X Domestic __ Public supply __ Industry
__ Irrigation __ Air conditioning __ Stock
__ Lawn __ Oil field water __ Other

9. Casing: Material Styrene Height: Above or below
Threaded __ Welded gl Surface 12 in.
RMP X PVC ___ Weight ___ lbs./ft.
Dia. 5 in. to 60 ft. depth Wall Thickness: inches or
Dia. ___ in. to ___ ft. depth gage No. .200

5. Type and color of material	From	To
Topsoil	0	3
Clay	3	25
Fine Sand	25	40
Gray Shale	40	60

(Use a second sheet if needed)

10. Screen: Manufacturer's name Sunflower Plastic
Type styrene Dia. 5"
Slot/~~gauze~~ .06 Length 18'
Set between 42 ft. and 60 ft.
___ ft. ond ___ ft.
Gravel pack? yes Size range of material 1/4-1/8"

11. Static water level: mo./day/yr.
31 ft. below land surface Date 6-5-78

12. Pumping level below land surfaces:
___ ft. after ___ hrs. pumping ___ g.p.m.
___ ft. after ___ hrs. pumping ___ g.p.m.
Estimated maximum yield ___ g.p.m.

13. Water sample submitted: mo./day/yr.
___ Yes ___ No Date ___

14. Well head completion: capped
___ Pitless adapter 12 Inches above grade

15. Well grouted? yes 1-2Fine Sand Mix
With: ___ Neat cement ___ Bentonite X Concrete
Depth: From 40" ft. to 14 ft.

16. Nearest source of possible contamination: Septic
ft. 60 Direction East Type Tank
Well disinfected upon completion? X Yes ___ No

17. Pump: X Not installed
Manufacturer's name ___
Model number ___ HP ___ Volts ___
Length of drop pipe ___ ft. capacity ___ g.p.m.
Type:
___ Submersible ___ Turbine
___ Jet ___ Reciprocating
___ Centrifugal ___ Other

18. Elevation:

Topography:
___ Hill
___ Slope
___ Upland
___ Valley

19. Remarks: Flat Ground

20. Water well contractor's certification:
This well was drilled under my jurisdiction and this report is true to the best of my knowledge and belief.
Harp Well & Pump 236
Business name License No.
Address Wichita, Kansas 67209
Signed M. Arnold Date 7-27-78
Authorized representative

T 29 R 2 E/W Sec 32 1/4 1/4 1/4 SWSE

Forward the white, blue and pink copies to the Department of Health and Environment

Form WWC-5

MI-1023