


1 LOCATION OF WATER WELL: Fraction NE 1/4 NW 1/4 SE 1/4 Section Number 33 Township Number T 29 S Range Number R 2 E/W
 County: Sedawick
 Distance and direction from nearest town or city street address of well if located within city?
1 - East ~~1/2 mile~~ of Mulvane

2 WATER WELL OWNER: Ida Baker R2 Box 10 67230
 RR#, St. Address, Box # : Mulvane Kan
 City, State, ZIP Code : Mulvane Kan
 Board of Agriculture, Division of Water Resources
 Application Number:

3 LOCATE WELL'S LOCATION WITH AN "X" IN SECTION BOX:

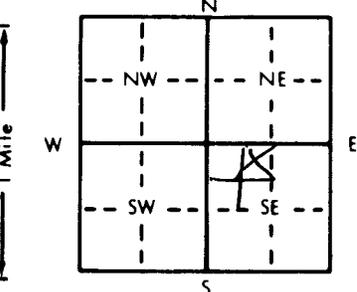

4 DEPTH OF COMPLETED WELL 85 ft. ELEVATION: ft.
 Depth(s) Groundwater Encountered 1 70 ft. 2. ft. 3. ft.
 WELL'S STATIC WATER LEVEL 35 ft. below land surface measured on mo/day/yr
 Pump test data: Well water was ft. after hours pumping gpm
 Est. Yield 10 gpm: Well water was ft. after hours pumping gpm
 Bore Hole Diameter 8 1/2 in. to ft., and in. to ft.
 WELL WATER TO BE USED AS:
 1 Domestic 3 Feedlot 6 Oil field water supply 9 Dewatering 12 Other (Specify below)
 2 Irrigation 4 Industrial 7 Lawn and garden only 10 Monitoring well
 Was a chemical/bacteriological sample submitted to Department? Yes No X If yes, mo/day/yr sample was submitted
 Water Well Disinfected? Yes X No

5 TYPE OF BLANK CASING USED:
 1 Steel 3 RMP (SR) 5 Wrought iron 8 Concrete tile CASING JOINTS: Glued X Clamped
 2 PVC 4 ABS 6 Asbestos-Cement 9 Other (specify below) Welded
 7 Fiberglass Threaded
 Blank casing diameter 5 in. to 60 ft., Dia in. to ft., Dia in. to ft.
 Casing height above land surface 18 in., weight 160 lbs./ft. Wall thickness or gauge No. 214

TYPE OF SCREEN OR PERFORATION MATERIAL:
 1 Steel 3 Stainless steel 5 Fiberglass 8 RMP (SR) 10 Asbestos-cement
 2 Brass 4 Galvanized steel 6 Concrete tile 9 ABS 11 Other (specify)
 12 None used (open hole)

SCREEN OR PERFORATION OPENINGS ARE:
 1 Continuous slot 3 Mill slot 5 Gauzed wrapped 8 Saw cut 11 None (open hole)
 2 Louvered shutter 4 Key punched 6 Wire wrapped 9 Drilled holes

SCREEN-PERFORATED INTERVALS: From 60 ft. to 85 ft., From ft. to ft.
 GRAVEL PACK INTERVALS: From ft. to ft., From ft. to ft.

6 GROUT MATERIAL: 1 Neat cement 2 Cement grout 3 Bentonite 4 Other
 Grout Intervals: From 0 ft. to 20 ft., From ft. to ft., From ft. to ft.
 What is the nearest source of possible contamination:
 1 Septic tank 4 Lateral lines 7 Pit privy 10 Livestock pens 14 Abandoned water well
 2 Sewer lines 5 Cess pool 8 Sewage lagoon 11 Fuel storage 15 Oil well/Gas well
 3 Watertight sewer lines 6 Seepage pit 9 Feedyard 12 Fertilizer storage 16 Other (specify below)
 13 Insecticide storage
 Direction from well? 5 How many feet? 100

FROM	TO	LITHOLOGIC LOG	FROM	TO	PLUGGING INTERVALS
<u>0</u>	<u>4</u>	<u>Soil</u>			
<u>4</u>	<u>12</u>	<u>Clay</u>			
<u>12</u>	<u>85</u>	<u>Shale + Lime</u>			

7 CONTRACTOR'S OR LANDOWNER'S CERTIFICATION: This water well was (1) constructed, (2) reconstructed, or (3) plugged under my jurisdiction and was completed on (mo/day/year) 7/6/90 and this record is true to the best of my knowledge and belief. Kansas Water Well Contractor's License No. 251 This Water Well Record was completed on (mo/day/yr) 7/18/90 under the business name of Winter Well Drill by (signature) Charles Winters

OFFICE USE ONLY
T
R
EW
SEC.
1/4
1/4
1/4