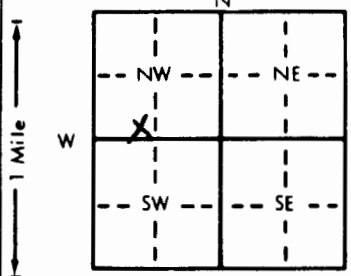


1 LOCATION OF WATER WELL: County: Neosho Fraction: SE 1/4 SW 1/4 NW 1/4 Section Number: 13 Township Number: T 29 S Range Number: R 20 EW

Distance and direction from nearest town or city street address of well if located within city?  
East Carroll Street St Paul, KS (Lots 8 & 10 of Block 17)

2 WATER WELL OWNER: Kenneth E Crager of St Francis 1st of St Paul  
 RR#, St. Address, Box #: Box 211 Board of Agriculture, Division of Water Resources  
 City, State, ZIP Code: St Paul, KS 66771 Application Number:

3 LOCATE WELL'S LOCATION WITH AN "X" IN SECTION BOX:  


4 DEPTH OF COMPLETED WELL: 39 ft. ELEVATION:  
 Depth(s) Groundwater Encountered 1. 30 ft. 2. ft. 3. ft.  
 WELL'S STATIC WATER LEVEL: 22 ft. below land surface measured on mo/day/yr  
 Pump test data: Well water was ft. after hours pumping gpm  
 Est. Yield 7 gpm: Well water was ft. after hours pumping gpm  
 Bore Hole Diameter: 10 in. to 39 ft., and in. to ft.  
 WELL WATER TO BE USED AS:  
 5 Public water supply 8 Air conditioning 11 Injection well  
 1 Domestic 3 Feedlot 6 Oil field water supply 9 Dewatering 12 Other (Specify below)  
 2 Irrigation 4 Industrial  Lawn and garden only 10 Monitoring well  
 Was a chemical/bacteriological sample submitted to Department? Yes.....No. .....; If yes, mo/day/yr sample was submitted  
 Water Well Disinfected? Yes No

5 TYPE OF BLANK CASING USED:  
 1 Steel 3 RMP (SR) 5 Wrought iron 8 Concrete tile CASING JOINTS: Glued  Clamped  
 PVC 4 ABS 7 Fiberglass 9 Other (specify below) Welded  
 Blank casing diameter 6 in. to 39 ft., Dia. in. to ft., Dia. in. to ft.  
 Casing height above land surface: 18 in., weight lbs./ft. Wall thickness or gauge No. SCH 40  
 TYPE OF SCREEN OR PERFORATION MATERIAL:  PVC 10 Asbestos-cement  
 1 Steel 3 Stainless steel 5 Fiberglass 8 RMP (SR) 11 Other (specify)  
 2 Brass 4 Galvanized steel 6 Concrete tile 9 ABS 12 None used (open hole)  
 SCREEN OR PERFORATION OPENINGS ARE:  
 1 Continuous slot 3 Mill slot 5 Gauzed wrapped  Saw cut 11 None (open hole)  
 2 Louvered shutter 4 Key punched 6 Wire wrapped 9 Drilled holes  
 7 Torch cut 10 Other (specify)  
 SCREEN-PERFORATED INTERVALS: From 22 ft. to 39 ft., From ft. to ft.  
 GRAVEL PACK INTERVALS: From 21 ft. to 39 ft., From ft. to ft.

6 GROUT MATERIAL:  Neat cement 2 Cement grout 3 Bentonite 4 Other  
 Grout intervals: From 0 ft. to 20 ft., From ft. to ft., From ft. to ft.  
 What is the nearest source of possible contamination:  
 1 Septic tank 4 Lateral lines 7 Pit privy 10 Livestock pens 14 Abandoned water well  
 2 Sewer lines 5 Cess pool 8 Sewage lagoon 11 Fuel storage 15 Oil well/Gas well  
 Watertight sewer lines 6 Seepage pit 9 Feedyard 12 Fertilizer storage 16 Other (specify below)  
 13 Insecticide storage  
 Direction from well? S How many feet? 40

FROM	TO	LITHOLOGIC LOG	FROM	TO	PLUGGING INTERVALS
0	4	Topsoil			
4	21	Clay			
21	30	Shale			
30	39	Sand & Gravel			

7 CONTRACTOR'S OR LANDOWNER'S CERTIFICATION: This water well was ( constructed, (2) reconstructed, or (3) plugged under my jurisdiction and was completed on (mo/day/year) 05-26-89 and this record is true to the best of my knowledge and belief. Kansas Water Well Contractor's License No. 508 This Water Well Record was completed on (mo/day/yr) 05-28-89 under the business name of Ashford Water Well Services by (signature) Leroy Ashford

INSTRUCTIONS: Use typewriter or ball point pen. PLEASE PRESS FIRMLY and PRINT clearly. Please fill in blanks, underline or circle the correct answers. Send top three copies to Kansas Department of Health and Environment, Bureau of Water Protection, Topeka, Kansas 66620-7320. Telephone: 913-296-5514. Send one to WATER WELL OWNER and retain one for your records.

OFFICE USE ONLY  
T  
R  
EW  
SEC.  
1/4  
1/4  
1/4