


1 LOCATION OF WATER WELL: Fraction SW SE SE SW Section Number 12 13 Township Number 29 T S Range Number 23 23 E W
 County: Crawford NE 1/4 SE 1/4 NW 1/4 NE 1/4

Street/Rural Address of Well Location; if unknown, distance & direction from nearest town or intersection: If at owner's address, check here

Global Positioning Systems (GPS) information:
 Latitude: 37.54056 37.514039 (in decimal degrees)
 Longitude: 94.62104 -94.843866 (in decimal degrees)
 Elevation: 918
 Horizontal Datum: WGS84, NAD83, NAD27
 Collection Method:

2 WATER WELL OWNER: Casey's General Stores
 RR#, St. Address, Box #: 105 W St. John
 City, State ZIP Code: Girard, KS 66743

GPS unit (Make/Model: MAGELLAN SPORT TRAK PR)
 Digital Map/Photo, Topographic Map, Land Survey
 Est. Accuracy: < 3 m, 3-5 m, 5-15 m, > 15 m

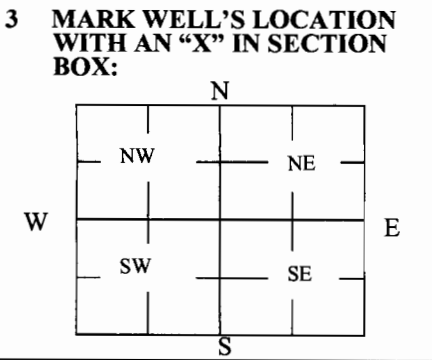

4 DEPTH OF WELL 12 ft.
 WELL'S STATIC WATER LEVEL 6 ft.
 WELL WAS USED AS:
 Domestic Public Water Supply Dewatering
 Irrigation Oil Field Water Supply Monitoring
 Feedlot Domestic (Lawn & Garden) Injection Well
 Industrial Air Conditioning Other _____
 Was a chemical/bacteriological sample submitted to Department? Yes No

5 TYPE OF BLANK CASING USED:
 Steel RMP (SR) Wrought Fiberglass Other (Specify below)
 PVC ABS Asbestos-Cement Concrete Tile rock lined
 Blank casing diameter 72 in. Was casing pulled? Yes No If yes, how much _____
 Casing height above or below land surface 60 below in.

6 GROUT PLUG MATERIAL: Neat cement Cement grout Bentonite Other _____
 Grout Plug Intervals: From 4 ft. to 6 ft., From _____ ft. to _____ ft., From _____ ft. to _____ ft.
 What is the nearest source of possible contamination:
 Septic tank Seepage pit Fuel storage Other (specify below) _____
 Sewer lines Pit privy Fertilizer storage _____
 Watertight sewer lines Sewage lagoon Insecticide storage _____
 Lateral lines Feedyard Abandoned water well Oil well/Gas well Direction from well? N
 Cess pool Livestock pens How many feet? 250'

| FROM | TO | PLUGGING MATERIALS | FROM | TO | PLUGGING MATERIALS |
|------|----|--------------------|------|----|--------------------|
| 6 | 12 | sand | | | |
| 4 | 6 | concrete | | | |
| 0 | 4 | soil | | | |
| | | | | | |
| | | | | | |
| | | | | | |

7 CONTRACTOR'S OR LANDOWNER'S CERTIFICATION: This water well was plugged under my jurisdiction and was completed on (mo/day/year) 12-6-2016 and this record is true to the best of my knowledge and belief. Kansas Water Well Contractor's License No. 841. This Water Well Record was completed on (mo/day/year) 12-30-2016 under the business name of Double J Energy, LLC by (signature) Charles Heckert

Send one white copy to Kansas Department of Health & Environment, Geology Section, 1000 SW Jackson Street, Ste. 420, Topeka, KS 66612-1367. Send one copy to WATER WELL OWNER and retain one for your records.
 Visit us at <http://www.kdheks.gov/waterwell/index.html> Telephone 785-296-5524.