


1 LOCATION OF WATER WELL: County: Crawford Fraction: SW 1/4 NW 1/4 SW 1/4 Section Number: 20 Township Number: T 29 S Range Number: R 25 E

Distance and direction from nearest town or city street address of well if located within city? 1 mi South Franklin KS

2 WATER WELL OWNER: Rick Elnicki
 RR#, St. Address, Box #: 130 S 69 Hwy
 City, State, ZIP Code: Pittsburg KS 66762
 Board of Agriculture, Division of Water Resources
 Application Number:

3 LOCATE WELL'S LOCATION WITH AN "X" IN SECTION BOX:

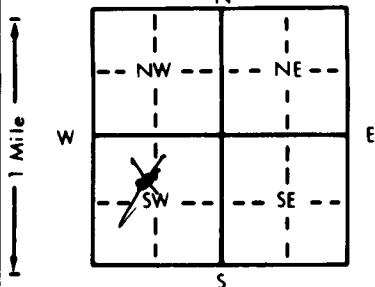

4 DEPTH OF COMPLETED WELL: ft. ELEVATION:
 Depth(s) Groundwater Encountered 1. .ft. 2. .ft. 3. .ft.
 WELL'S STATIC WATER LEVEL .ft. below land surface measured on mo/day/yr
 Pump test data: Well water was .ft. after . hours pumping . gpm
 Est. Yield . gpm: Well water was .ft. after . hours pumping . gpm
 Bore Hole Diameter .in. to .ft., and .in. to .ft.
 WELL WATER TO BE USED AS:
 1 Domestic 3 Feedlot 6 Oil field water supply 9 Dewatering 11 Injection well
 2 Irrigation 4 Industrial 7 Lawn and garden only 10 Monitoring well 12 Other (Specify below)
 Was a chemical/bacteriological sample submitted to Department? Yes . No .; If yes, mo/day/yr sample was submitted
 Water Well Disinfected? Yes . No .

5 TYPE OF BLANK CASING USED:
 1 Steel 3 RMP (SR) 5 Wrought iron 8 Concrete tile CASING JOINTS: Glued . Clamped .
 2 PVC 4 ABS 6 Asbestos-Cement 9 Other (specify below) Welded .
 7 Fiberglass Threaded .

Blank casing diameter .in. to .ft., Dia .in. to .ft., Dia .in. to .ft.
 Casing height above land surface 3' Below in., weight . lbs./ft. Wall thickness or gauge No. .

TYPE OF SCREEN OR PERFORATION MATERIAL:
 1 Steel 3 Stainless steel 5 Fiberglass 7 PVC 10 Asbestos-cement
 2 Brass 4 Galvanized steel 6 Concrete tile 8 RMP (SR) 11 Other (specify) .
 9 ABS 12 None used (open hole)

SCREEN OR PERFORATION OPENINGS ARE:
 1 Continuous slot 3 Mill slot 5 Gauzed wrapped 8 Saw cut 11 None (open hole)
 2 Louvered shutter 4 Key punched 6 Wire wrapped 9 Drilled holes
 7 Torch cut 10 Other (specify) .

SCREEN-PERFORATED INTERVALS: From .ft. to .ft., From .ft. to .ft., From .ft. to .ft.
 GRAVEL PACK INTERVALS: From .ft. to .ft., From .ft. to .ft., From .ft. to .ft.

6 GROUT MATERIAL: 1 Neat cement 2 Cement grout 3 Bentonite 4 Other .
 Grout Intervals: From .ft. to .ft., From 4.5 ft., From .ft. to .ft., From .ft. to .ft.
 What is the nearest source of possible contamination:
 1 Septic tank 4 Lateral lines 7 Pit privy 11 Fuel storage 15 Oil well/Gas well
 2 Sewer lines 5 Cess pool 8 Sewage lagoon 12 Fertilizer storage 16 Other (specify below)
 3 Watertight sewer lines 6 Seepage pit 9 Feedyard 13 Insecticide storage

Direction from well? How many feet?

FROM	TO	LITHOLOGIC LOG	FROM	TO	PLUGGING INTERVALS
			0	4.5	Tremi Pipe & Bentonite Grout Pumped

7 CONTRACTOR'S OR LANDOWNER'S CERTIFICATION: This water well was (1) constructed, (2) reconstructed, or (3) plugged under my jurisdiction and was completed on (mo/day/year) 5/10/96 and this record is true to the best of my knowledge and belief. Kansas Water Well Contractor's License No. 419 This Water Well Record was completed on (mo/day/yr) 6/10/96 under the business name of Freddy Vans by (signature) Fred Von Beekman