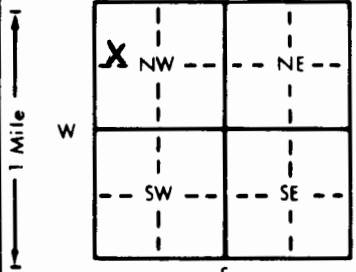


1 LOCATION OF WATER WELL: County: Butler	Fraction SW 1/4 NW 1/4 NW 1/4	Section Number 5	Township Number T 29 S	Range Number R 3 (EW)
--	---	----------------------------	----------------------------------	--

Distance and direction from nearest town or city street address of well if located within city?

101 E. Berry, Rose Hill, Kansas

2 WATER WELL OWNER: RR#, St. Address, Box # : City, State, ZIP Code	Midtown Services Attn: Dick Showalter P.O. Box 23, Rose Hill, Ks 67133	Board of Agriculture, Division of Water Resources Application Number: _____
---	---	--

3 LOCATE WELL'S LOCATION WITH AN "X" IN SECTION BOX: 	4 DEPTH OF COMPLETED WELL: 4D ft. ELEVATION: _____ Depth(s) Groundwater Encountered 1. 33 ft. 2. _____ ft. 3. _____ ft. WELL'S STATIC WATER LEVEL 34.46 ft. below land surface measured on mo/day/yr 7/23/96 Pump test data: Well water was _____ ft. after _____ hours pumping _____ gpm Est. Yield _____ gpm: Well water was _____ ft. after _____ hours pumping _____ gpm Bore Hole Diameter: 8.625 in. to 41 ft. and _____ in. to _____ ft. WELL WATER TO BE USED AS: 5 Public water supply 8 Air conditioning 11 Injection well 1 Domestic 3 Feedlot 6 Oil field water supply 9 Dewatering 12 Other (Specify below) 2 Irrigation 4 Industrial 7 Lawn and garden only 10 Monitoring well mw-7 Was a chemical/bacteriological sample submitted to Department? Yes _____ No X If yes, mo/day/yr sample was submitted _____ Water Well Disinfected? Yes _____ No X
--	--

5 TYPE OF BLANK CASING USED: 1 Steel 3 RMP (SR) 5 Wrought iron 8 Concrete tile 2 PVC 4 ABS 6 Asbestos-Cement 9 Other (specify below) Blank casing diameter 2 in. to 25 ft. Dia _____ in. to _____ ft. Dia _____ in. to _____ ft. Casing height above land surface _____ in. weight SCH 40 PVC lbs./ft. Wall thickness or gauge No. _____ TYPE OF SCREEN OR PERFORATION MATERIAL: 1 Steel 3 Stainless steel 5 Fiberglass 8 RMP (SR) 10 Asbestos-cement 2 Brass 4 Galvanized steel 6 Concrete tile 9 ABS 11 Other (specify) _____ 12 None used (open hole) SCREEN OR PERFORATION OPENINGS ARE: 1 Continuous slot 3 Mill slot 5 Gauzed wrapped 8 Saw cut 11 None (open hole) 2 Louvered shutter 4 Key punched 6 Wire wrapped 9 Drilled holes 7 Torch cut 10 Other (specify) _____ SCREEN-PERFORATED INTERVALS: From 25 ft. to 40 ft. From _____ ft. to _____ ft. From _____ ft. to _____ ft. From _____ ft. to _____ ft. GRAVEL PACK INTERVALS: From 24 ft. to 40 ft. From _____ ft. to _____ ft. From _____ ft. to _____ ft. From _____ ft. to _____ ft.
--

6 GROUT MATERIAL: 1 Neat cement 2 Cement grout 3 Bentonite 4 Other _____ Grout Intervals: From 2 ft. to 21 ft. From 3 ft. to 21 ft. From 24 ft. to _____ ft. What is the nearest source of possible contamination: 1 Septic tank 4 Lateral lines 7 Pit privy 10 Livestock pens 14 Abandoned water well 2 Sewer lines 5 Cess pool 8 Sewage lagoon 11 Fuel storage 15 Oil well/Gas well 3 Watertight sewer lines 6 Seepage pit 9 Feedyard 12 Fertilizer storage 16 Other (specify below) 13 Insecticide storage Direction from well? _____ How many feet? _____ Contaminated Si

FROM	TO	LITHOLOGIC LOG	FROM	TO	PLUGGING INTERVALS
GL	0.50	Fill			
0.50	15.50	Silty Clay			
15.50	18.00	Limestone, hard			
18.00	26.00	Shale			
26.00	26.25	Limestone			
26.25	30.00	Shale			
30.00	30.25	Limestone			
30.25	38.50	Shale			
38.00	41.00	Limestone			
41.00	TD	End of borehole			
					Flush Mount waiver D.Taylor

7 CONTRACTOR'S OR LANDOWNER'S CERTIFICATION: This water well was (1) constructed, (2) reconstructed, or (3) plugged under my jurisdiction and was completed on (mo/day/year) 7/29/96 and this record is true to the best of my knowledge and belief. Kansas Water Well Contractor's License No. 585 This Water Well Record was completed on (mo/day/yr) _____ under the business name of Associated Environmental, Inc. by (signature) D. Johnson 7/22/96
