WATER WELL RECORD Form WWC-5 KSA 82a-1212

1 LOCATION OF WATER WELL: County: Butler | Fraction: NE¼ SW¼ NE¼ | Section Number: 3 | Township Number: T 29 S | Range Number: R 3 (E) W

Distance and direction from nearest town or city street address of well if located within city? 628 E Showalter Rose Hill

2 WATER WELL OWNER: Steven K Gier

RR#, St. Address, Box # : 628 E Showalter

City, State, ZIP Code : Rose Hill, Ks 67133

Board of Agriculture, Division of Water Resour

Application Number:

3 LOCATE WELL'S LOCATION WITH AN "X" IN SECTION BOX:

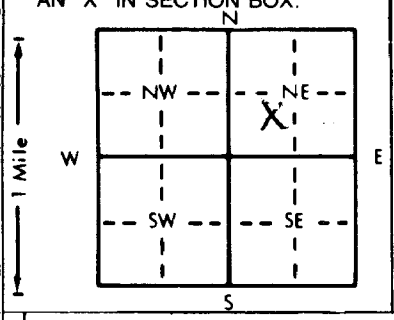

4 DEPTH OF COMPLETED WELL 90 ft. ELEVATION:

Depth(s) Groundwater Encountered 1. 82 ft. 2. ft. 3. f

WELL'S STATIC WATER LEVEL 18 ft. below land surface measured on mo/day/yr

Pump test data: Well water was ft. after hours pumping gp

Est. Yield 40+ gpm: Well water was ft. after hours pumping gp

Bore Hole Diameter 10 in. to ft., and in. to

WELL WATER TO BE USED AS: 1 Domestic 2 Irrigation 3 Feedlot 4 Industrial 5 Public water supply 6 Oil field water supply (7) Lawn and garden only 8 Air conditioning 9 Dewatering 10 Monitoring well 11 Injection well 12 Other (Specify below)

Was a chemical/bacteriological sample submitted to Department? Yes No ✓; If yes, mo/day/yr sample was s mitted

Water Well Disinfected? Yes No

5 TYPE OF BLANK CASING USED: 1 Steel (2) PVC 3 RMP (SR) 4 ABS 5 Wrought iron 6 Asbestos-Cement 7 Fiberglass 8 Concrete tile 9 Other (specify below)

CASING JOINTS: Glued Clamped Welded Threaded

Blank casing diameter 5 in. to ft., Dia in. to ft., Dia in. to

Casing height above land surface 12 in., weight 160 lbs./ft. Wall thickness or gauge No.

TYPE OF SCREEN OR PERFORATION MATERIAL: 1 Steel 2 Brass 3 Stainless steel 4 Galvanized steel 5 Fiberglass 6 Concrete tile (7) PVC 8 RMP (SR) 9 ABS 10 Asbestos-cement 11 Other (specify) 12 None used (open hole)

SCREEN OR PERFORATION OPENINGS ARE: 1 Continuous slot (3) Mill slot 2 Louvered shutter 4 Key punched 5 Gauzed wrapped 6 Wire wrapped 7 Torch cut 8 Saw cut 9 Drilled holes 10 Other (specify) 11 None (open hole)

SCREEN-PERFORATED INTERVALS: From 70 ft. to 90 ft., From ft. to

From ft. to ft., From ft. to

GRAVEL PACK INTERVALS: From 20 ft. to 90 ft., From ft. to

From ft. to ft., From ft. to

6 GROUT MATERIAL: 1 Neat cement 2 Cement grout (3) Bentonite 4 Other

Grout Intervals: From 3 ft. to 20 ft., From ft. to ft., From ft. to

What is the nearest source of possible contamination: 1 Septic tank 2 Sewer lines (3) Watertight sewer lines 4 Lateral lines 5 Cess pool 6 Seepage pit 7 Pit privy 8 Sewage lagoon 9 Feedyard 10 Livestock pens 11 Fuel storage 12 Fertilizer storage 13 Insecticide storage 14 Abandoned water well 15 Oil well/Gas well 16 Other (specify below)

Direction from well? North How many feet? 25

FROM	TO	LITHOLOGIC LOG	FROM	TO	PLUGGING INTERVALS
0	4	dirt			
4	8	brown clay			
8	45	yellow clay			
45	68	grey shale			
68	90	shaley lime			

7 CONTRACTOR'S OR LANDOWNER'S CERTIFICATION: This water well was (1) constructed, (2) reconstructed, or (3) plugged under my jurisdiction and w completed on (mo/day/year) 6/17/99 and this record is true to the best of my knowledge and belief. Kans Water Well Contractor's License No. 493 This Water Well Record was completed on (mo/day/yr) 6/17/99 under the business name of Reiserer Well Drilling by (signature) Gary Reiserer

INSTRUCTIONS: Use typewriter or ball point pen. *PLEASE PRESS FIRMLY* and *PRINT* clearly. Please fill in blanks, underline or circle the correct answers. Send top three copies to Kansas Department of Health and Environment, Bureau of Water, Topeka, Kansas 66620-0001. Telephone: 913-296-5545. Send one to WATER WELL OWNER and retain one for your records.