


4 M East of Rose Hill

3 LOCATE WELL'S LOCATION WITH AN "X" IN SECTION BOX. 4 DEPTH OF COMPLETED WELL. 125 ft. ELEVATION: 25

3 LOCATE WELL'S LOCATION WITH AN "X" IN SECTION BOX. 4 DEPTH OF COMPLETED WELL. 125 ft. ELEVATION: 25

Depth(s) Groundwater Encountered 1. 0.0 ft. 2. _____ ft. 3. _____ ft.

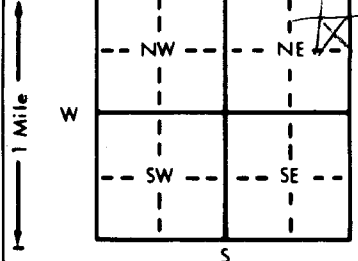

4 DEPTH OF COMPLETED WELL. 125 ft. ELEVATION:

Depth(s) Groundwater Encountered 1. 0 ft. 2. _____ ft. 3. _____ ft.

WELLS STATIC WATER LEVEL: 7.5 ft. below land surface measured on mo/day/yr

Pump test data: Well water was _____ ft after _____ hours pumping _____ gpm

Est. Yield	gpm	Well water was	ft. after	hours pumping	gpm
------------	-----	----------------	-----------	---------------	-----

Bore Hole Diameter 7 1/2 in. to ft., and in. to ft.

WELL WATER TO BE USED AS:

1 Domestic	2 Feedlot	3 Public water supply	4 Air conditioning	5 Injection well
6 Oil field water supply	7 Dewatering	8 Other (Specify below)		

1 Domestic	3 Feedlot	5 Oil field water supply	9 Dewatering	12 Other (Specify below)
2 Irrigation	4 Industrial	7 Lawn and garden only	10 Monitoring well	

Was a chemical/bacteriological sample submitted to Department? Yes.....No.....☒.....; If yes, mo/day/yr sample was sub-

mitted						Water Well Disinfected? Yes ☒ No ☐
--------	--	--	--	--	--	---

5 TYPE OF BLANK CASING USED: 5 Wrought iron 8 Concrete tile CASING JOINTS: Glued Clamped
1 Steel 3 RMP (SR) 6 Asbestos-Cement 9 Other (specify below) Welded

② PVC	4 ABS	7 Fiberglass		Welded.....	Threaded.....
-------	-------	--------------	-------	-------------	---------------

Blank casing diameter . . . 5 in. to 60 ft., Dia . . . 143 in. to 34 ft.

Casing height above land surface 18 in., weight 100 lbs./ft. Wall thickness or gauge No. 214
TYPE OF SCREEN OR PERFORATION MATERIAL: 3 PVC 10. Asbestos-cement

TYPE OF SCREEN OR FIBERGLASS MATERIAL:				
1 Steel	3 Stainless steel	5 Fiberglass	8 RMP (SR)	11 Other (specify) _____

2 Brass	4 Galvanized steel	6 Concrete tile	9 ABS	12 None used (open hole)
---------	--------------------	-----------------	-------	--------------------------

SCREEN OR PERFORATION OPENINGS ARE:

1 Continuous slot	2 Mill slot	5 Gauzed wrapped	8 Saw cut	11 None (open hole)
3 Wire wrapped	4 Drilled holes			

1 Continuous slot	3 Mill slot	6 Wire wrapped	9 Drilled holes
2 Louvered shutter	4 Key punched	7 Torch cut	10 Other (specify) _____

SCREEN-PERFORATED INTERVALS: From 60 ft. to 125 ft., From _____ ft. to _____ ft.

From 35 ft. to 43 ft. From _____ ft. to _____ ft.

GRAVEL PACK INTERVALS: From 25 ft. to 725 ft. From _____ ft. to _____ ft.
From _____ ft. to _____ ft. From _____ ft. to _____ ft.

		From	to	From	to
6	GROUT MATERIAL:	1 Neat cement	2 Cement grout	3 Bentonite	4 Other

Grout Intervals: From 3 ft. to 23 ft., From 0 ft. to ft., From ft. to ft.

What is the nearest source of possible contamination:			10 Livestock pens	14 Abandoned water well

1 Septic tank	4 Lateral lines	7 Pit privy	11 Fuel storage	15 Oil well/Gas well
2 Sewer lines	5 Cess pool	8 Sewage lagoon	12 Fertilizer storage	16 Other (specify below)

3 Watertight sewer lines	6 Seepage pit	9 Feedyard	12 Fertilizer storage	15 Other (specify below)
			13 Insecticide storage	

Direction from well?		How many feet?	
FROM	TO	FROM	TO

FROM	TO	LITHOLOGIC LOG	FROM	TO	FLUGGING INTERVALS
0	3	Soil			

3	30	Chay				
---	----	------	--	--	--	--

30	125	Limst & Shale			
----	-----	---------------	--	--	--

[illegible][illegible][illegible][illegible][illegible][illegible][illegible][illegible][illegible]

7 CONTRACTOR'S OR LANDOWNER'S CERTIFICATION: This water well was (1) constructed, (2) reconstructed, or (3) plugged under my jurisdiction and was

completed on (mo/day/year) 4/24/00 and this record is true to the best of my knowledge and belief. Kansas

Water Well Contractor's License No. 207 This Water Well Record was completed on (mo/day/yr) 3/8/00
under the business name of Water Well Drill by (signature) [Signature]

INSTRUCTIONS: Use typewriter or ball point pen. PLEASE PRESS FIRMLY and PRINT clearly. Please fill in blanks, underline or circle the correct answers. Send top three copies to Kansas Department

of Health and Environment, Bureau of Water, Topeka, Kansas 66620-0001. Telephone: 913-296-5545. Send one to WATER WELL OWNER and retain one for your records.