

1 LOCATION OF WATER WELL:	Fraction	Section Number	Township Number	Range Number
County: <u>Butler</u>	<u>C</u> $\frac{1}{4}$ NW $\frac{1}{4}$ NE $\frac{1}{4}$	<u>5</u>	T <u>29</u> S	R <u>3E</u> EW

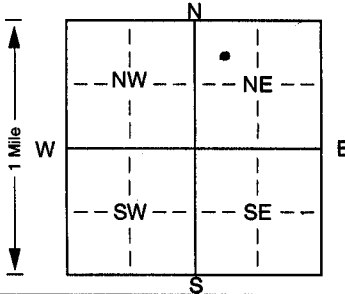
Distance and direction from nearest town or city street address of well if located within city?

552 Plumwood Dr., Rose Hill, KS

2 WATER WELL OWNER: <u>Scott Robson</u>	Board of Agriculture, Division of Water Resources
RR#, St. Address, Box #: <u>552 Plumwood Dr.</u>	Application Number:
City, State, ZIP Code: <u>Rose Hill, KS 67133</u>	

3 LOCATE WELL'S LOCATION WITH	4 DEPTH OF COMPLETED WELL: <u>100'</u> ft. ELEVATION:
-------------------------------	---

AN "X" IN SECTION BOX:

Depth(s) Groundwater Encountered 1 ft. 2. ft. 3. ft. 4-22-02 ft.WELL'S STATIC WATER LEVEL 45 ft. below land surface measured on mo/day/yr

Pump test data: Well water was ft. after hours pumping gpm

Est. Yield gpm: Well water was ft. after hours pumping gpm

Bore Hole Diameter 9 in. to ft. and in. to ft.

WELL WATER TO BE USED AS: 5 Public water supply 8 Air conditioning 11 Injection well

1 Domestic 3 Feedlot 6 Oil field water supply 9 Dewatering 12 Other (Specify below)

2 Irrigation 4 Industrial 8 Domestic (lawn & garden) 10 Monitoring well

Was a chemical/bacteriological sample submitted to Department? Yes. No. X; If yes, mo/day/yr sample was submitted Water Well Disinfected? Yes X No

5 TYPE OF BLANK CASING USED:	5 Wrought iron	8 Concrete tile	CASING JOINTS: Glued. <u>X</u> Clamped.
------------------------------	----------------	-----------------	---

1 Steel 3 RMP (SR) 6 Asbestos-Cement 9 Other (specify below) Welded

2 PVC 4 ABS 7 Fiberglass ThreadedBlank casing diameter 5 in. to 80 ft., Dia in. to ft., Dia in. to ft.Casing height above land surface 12 in., weight lbs./ft. Wall thickness or gauge No. SDR26

TYPE OF SCREEN OR PERFORATION MATERIAL:

1 Steel 3 Stainless steel 5 Fiberglass 8 RMP (SR) 10 Asbestos-cement

2 Brass 4 Galvanized steel 6 Concrete tile 9 ABS 11 Other (specify)

SCREEN OR PERFORATION OPENINGS ARE: 5 Gauzed wrapped 8 Saw cut 11 None (open hole)

1 Continuous slot 3 Mill slot 6 Wire wrapped 9 Drilled holes

2 Louvered shutter 4 Key punched 7 Torch cut 10 Other (specify) ft.

SCREEN-PERFORATED INTERVALS: From 80 ft. to 100 ft., From ft. to ft.

From ft. to ft., From ft. to ft.

GRAVEL PACK INTERVALS: From 20 ft. to 100 ft., From ft. to ft.

From ft. to ft., From ft. to ft.

6 GROUT MATERIAL:	1 Neat cement	2 Cement grout	<u>3</u> Bentonite	4 Other
-------------------	---------------	----------------	--------------------	---------

Grout Intervals: From 7 ft. to 20 ft., From ft. to ft., From ft. to ft.

What is the nearest source of possible contamination:

1 Septic tank 4 Lateral lines 7 Pit privy 10 Livestock pens 14 Abandoned water well

2 Sewer lines 5 Cess pool 8 Sewage lagoon 11 Fuel storage 15 Oil well/Gas well

3 Watertight sewer lines 6 Seepage pit 9 Feedyard 12 Fertilizer storage 16 Other (specify below)

Direction from well? How many feet?

FROM TO LITHOLOGIC LOG FROM TO PLUGGING INTERVALS

0 24 dry

24 38 shale 38-39 lime

38 50 shale

50 65 lime w/shale str

65 85 lime

85 100 dirty lime

7 CONTRACTOR'S OR LANDOWNER'S CERTIFICATION: This water well was <u>(1)</u> constructed, (2) reconstructed, or (3) plugged under my jurisdiction and was completed on (mo/day/year) <u>4-22-02</u> and this record is true to the best of my knowledge and belief. Kansas Water Well Contractor's Licence No. <u>171</u> This Water Well Record was completed on (mo/day/yr) <u>4-26-02</u> under the business name of <u>G & S Drilling Inc.</u> by (signature) <u>[Signature]</u>
