

WATER WELL RECORD Form WWC-5


Division of Water Resources App. No.

Well ID

Original Record Correction Change in Well Use

1 LOCATION OF WATER WELL: County: Butler Fraction NW 1/4 NE 1/4 NE 1/4 NE 1/4 Section Number 1 Township Number T 29 S Range Number R 3 E W

2 WELL OWNER: Last Name: Lindquist First: Lee Street or Rural Address where well is located (if unknown, distance and direction from nearest town or intersection): If at owner's address, check here: 11039 SW 180th St. - Rose Hill, Kansas 67113

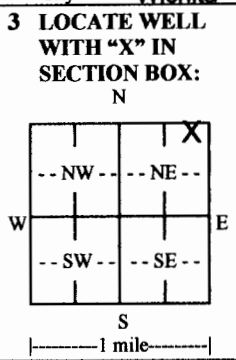

3 LOCATE WELL WITH 'X' IN SECTION BOX: N W E S 1 mile
4 DEPTH OF COMPLETED WELL: 200 ft. Depth(s) Groundwater Encountered: 1) ... ft. 2) ... ft. 3) ... ft., or 4) Dry Well
WELL'S STATIC WATER LEVEL: ... ft.
Pump test data: Well water was ... ft. after ... hours pumping ... gpm
Estimated Yield: ... gpm
Bore Hole Diameter: 5 in. to 200 ft. and ... in. to ... ft.

5 Latitude: 37.562799 (decimal degrees) Longitude: 97.044995 (decimal degrees) Datum: WGS 84 NAD 83 NAD 27
Source for Latitude/Longitude: GPS (unit make/model: ... (WAAS enabled: Yes No) Land Survey Topographic Map Online Mapper:
6 Elevation: 1260 ft. Ground Level TOC Source: Land Survey GPS Topographic Map Other: KOLAR

7 WELL WATER TO BE USED AS: 1. Domestic: Household Lawn & Garden Livestock Irrigation Feedlot Industrial
2. Public Water Supply: well ID
3. Dewatering: how many wells?
4. Aquifer Recharge: well ID
5. Monitoring: well ID
6. Environmental Remediation: well ID
7. Air Sparge Soil Vapor Extraction Recovery Injection
8. Oil Field Water Supply: lease
9. Test Hole: well ID Cased Uncased Geotechnical
10. Geothermal: how many bores? 3
a) Closed Loop Horizontal Vertical
b) Open Loop Surface Discharge Inj. of Water
11. Other (specify):

Was a chemical/bacteriological sample submitted to KDHE? Yes No If yes, date sample was submitted:
Water well disinfected? Yes No

8 TYPE OF CASING USED: Steel PVC Other Polyethylene CASING JOINTS: Glued Clamped Welded Threaded
Casing diameter: 7.5 in. to 200 ft., Diameter ... in. to ... ft., Diameter ... in. to ... ft.
Casing height above land surface: 0 in. Weight ... lbs./ft. Wall thickness or gauge No. 0.95
TYPE OF SCREEN OR PERFORATION MATERIAL: Steel Stainless Steel Fiberglass PVC Other (Specify)
Brass Galvanized Steel Concrete tile None used (open hole)
SCREEN OR PERFORATION OPENINGS ARE: Continuous Slot Mill Slot Gauze Wrapped Torch Cut Drilled Holes Other (Specify)
Louvered Shutter Key Punched Wire Wrapped Saw Cut None (Open Hole)
SCREEN-PERFORATED INTERVALS: From ... ft. to ... ft., From ... ft. to ... ft., From ... ft. to ... ft.
GRAVEL PACK INTERVALS: From ... ft. to ... ft., From ... ft. to ... ft., From ... ft. to ... ft.

9 GROUT MATERIAL: Neat cement Cement grout Bentonite Other
Grout Intervals: From 0 ft. to 200 ft., From ... ft. to ... ft., From ... ft. to ... ft.
Nearest source of possible contamination: Septic Tank Lateral Lines Pit Privy Livestock Pens Insecticide Storage
Sewer Lines Cess Pool Sewage Lagoon Fuel Storage Abandoned Water Well
Watertight Sewer Lines Seepage Pit Feedyard Fertilizer Storage Oil Well/Gas Well
Other (Specify)
Direction from well? Southeast Distance from well? 50 ft.

Table with columns: 10 FROM, TO, LITHOLOGIC LOG, FROM, TO, LITHO. LOG (cont.) or PLUGGING INTERVALS. Rows include Topsoil, Clay, Limestone/shale, Shale, limestone w/smalla fracs, Shale w/limestone layers.

11 CONTRACTOR'S OR LANDOWNER'S CERTIFICATION: This water well was constructed, reconstructed, or plugged under my jurisdiction and was completed on (mo-day-year) 11/5/2015 and this record is true to the best of my knowledge and belief. Kansas Water Well Contractor's License No. 897. This Water Well Record was completed on (mo-day-year) 11/9/2015 under the business name of Peterson McNett Drilling, Inc.