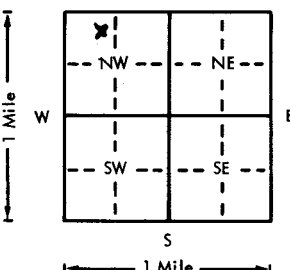
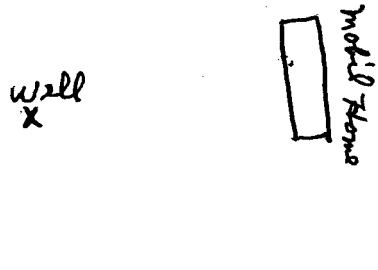


USE TYPEWRITER OR BALL
POINT PEN-PRESS FIRMLY,
PRINT CLEARLY.

WATER WELL RECORD
KSA 82a-1201-1215

Kansas Department of Health and
Environment-Division of Environment
(Water well Contractors)
Topeka, Kansas 66620

1. Location of well:		County <u>Butler</u>	Fraction <u>NE 1/4 NW 1/4 NW 1/4</u>	Section number <u>1</u>	Township number <u>T 29 S</u>	Range number <u>R 3 E</u>
2. Distance and direction from nearest town or city: Street address of well location if in city:		<u>4 1/2 mi E</u> <u>of Rose Hill</u>		Owner of well: <u>Jack Tanning</u> R. or street: <u>Dalton</u> City, state, zip code:		
4. Locate with "X" in section below:		Sketch map:		6. Bore hole dia. <u>10</u> in. Completion date <u>5-9-1978</u> Well depth <u>70</u> ft.		
				7. ☒ Cable tool ☐ Rotary ☐ Driven ☐ Dug ☐ Hollow rod ☐ Jetted ☐ Bored ☐ Reverse rotary		
5. Type and color of material		From		To		8. Use: ☒ Domestic ☐ Public supply ☐ Industry ☐ Irrigation ☐ Air conditioning ☐ Stock ☐ Lawn ☐ Oil field water ☐ Other
		Black Soil		0 4		9. Casing: Material <u>102</u> Height: <u>Above</u> or below Threaded ☐ Welded ☒ Surface <u>12</u> in. RMP ☒ PVC ☐ Weight <u>90</u> lbs./ft. Dia. <u>6</u> in. to <u>40</u> ft. depth Wall Thickness: inches or Dia. <u>6</u> in. to <u>70</u> ft. depth gage No. <u>175</u>
		yellow shale		4 12		10. Screen: Manufacturer's name <u>GTZ</u> Type <u>RMP</u> Dia. <u>6</u> Slo/gauze <u>1/4 40</u> Length <u>20 ft</u> Set between <u>40</u> ft. and <u>60</u> ft. ft. and ft. Gravel pack? <u>no</u> Size range of material
		grey shale		12 19		11. Static water level: <u>34</u> ft. below land surface Date <u>5-9-1978</u> mo./day/yr.
		grey lime		19 28		12. Pumping level below land surfaces: ft. after hrs. pumping g.p.m. ft. after hrs. pumping g.p.m. Estimated maximum yield <u>20 ft</u> g.p.m.
		grey shale		28 33		13. Water sample submitted: <u>Yes</u> ☒ No ☐ Date
		yellow lime		33 51		14. Well head completion: Pitless adapter <u>12</u> inches above grade
		water		51		15. Well grouted? <u>yes</u> With: ☒ Neat cement ☐ Bentonite ☐ Concrete Depth: From <u>0</u> ft. to <u>10</u> ft.
		yellow lime		51 70		16. Nearest source of possible contamination: ft. <u>75</u> Direction <u>SE</u> Type <u>Septic</u> Well disinfected upon completion? ☒ Yes ☐ No
						17. Pump: Not installed Manufacturer's name <u>Moulds</u> Model number <u>10FJ</u> HP <u>1/2</u> Volts <u>230</u> Length of drop pipe <u>65</u> ft. capacity <u>10</u> g.p.m. Type: ☒ Submersible ☐ Turbine ☐ Jet ☐ Reciprocating ☐ Centrifugal ☐ Other
18. Elevation:		19. Remarks:		20. Water well contractor's certification: This well was drilled under my jurisdiction and this report is true to the best of my knowledge and belief. <u>Wike Well Drilling</u> <u>122</u> Business name License No. Address <u>Route 3 Box 57 Augusta</u> Signed <u>Thurman Wike</u> Date <u>5-9-1978</u> Authorized representative		
Topography: ☐ Hill ☐ Slope ☒ Upland ☐ Valley		<u>owner will put on slab</u> <u>Dalton Tanning</u>				

Forward the white, blue and pink copies to the Department of Health and Environment

Form WWC-5