


1 LOCATION OF WATER WELL: County: Butler Fraction: NE 1/4 NW 1/4 Section Number: 5 Township Number: T 29 S Range Number: R 3 EW

Distance and direction from nearest town or city street address of well if located within city?

1 East of Rose Hill

2 WATER WELL OWNER: Hayden Const. Rose Hill KS
 RR#, St. Address, Box #: 100 East Lilknitter 67133
 City, State, ZIP Code: 100 East Lilknitter 67133 Board of Agriculture, Division of Water Resources
 Application Number:

3 LOCATE WELL'S LOCATION WITH AN "X" IN SECTION BOX:

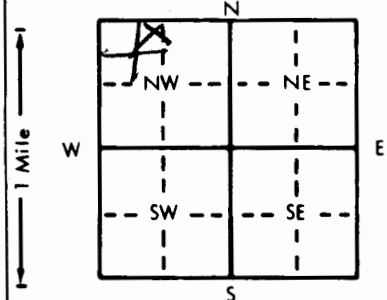

4 DEPTH OF COMPLETED WELL: 65 ft. ELEVATION: 45 ft.


WELL'S STATIC WATER LEVEL: 20 ft. below land surface measured on mo/day/yr

Pump test data: Well water was 30 gpm. Well water was 65 ft. after 85 hours pumping 65 gpm

Est. Yield 30 gpm. Well water was 65 ft. after 85 hours pumping 65 gpm

Bore Hole Diameter: 8 1/2 in. to 65 ft., and 65 in. to 65 ft.

WELL WATER TO BE USED AS: 5 Public water supply 8 Air conditioning 11 Injection well

1 Domestic 3 Feedlot 6 Oil field water supply 9 Dewatering 12 Other (Specify below)

2 Irrigation 4 Industrial 7 Lawn and garden only 10 Observation well

Was a chemical/bacteriological sample submitted to Department? Yes No; If yes, mo/day/yr sample was submitted

Water Well Disinfected? Yes No

5 TYPE OF BLANK CASING USED: 1 Steel 3 RMP (SR) 5 Wrought iron 8 Concrete tile CASING JOINTS: Glued X Clamped

2 PVC 4 ABS 6 Asbestos-Cement 9 Other (specify below) Welded


Casing height above land surface: 18 in., weight 18 lbs./ft. Wall thickness or gauge No. 214

TYPE OF SCREEN OR PERFORATION MATERIAL: 1 Steel 3 Stainless steel 5 Fiberglass 7 PVC 10 Asbestos-cement

2 Brass 4 Galvanized steel 6 Concrete tile 8 RMP (SR) 11 Other (specify)

SCREEN OR PERFORATION OPENINGS ARE: 1 Continuous slot 3 Mill slot 5 Gauzed wrapped 8 Saw cut 11 None (open hole)

2 Louvered shutter 4 Key punched 6 Wire wrapped 9 Drilled holes



6 GROUT MATERIAL: 1 Neat cement 2 Cement grout 3 Bentonite 4 Other


What is the nearest source of possible contamination: 1 Septic tank 4 Lateral lines 7 Pit privy 10 Livestock pens 14 Abandoned water well

2 Sewer lines 5 Cess pool 8 Sewage lagoon 11 Fuel storage 15 Oil well/Gas well

3 Watertight sewer lines 6 Seepage pit 9 Feedyard 12 Fertilizer storage 16 Other (specify below)

Direction from well? East How many feet? 200

FROM TO LITHOLOGIC LOG FROM TO LITHOLOGIC LOG

0 3 Soil 0 3 Soil

3 120 Clay 3 120 Clay

12 250 Clay & Rock 12 250 Clay & Rock

25 65 Lime & Shale 25 65 Lime & Shale

7 CONTRACTOR'S OR LANDOWNER'S CERTIFICATION: This water well was (1) constructed, (2) reconstructed, or (3) plugged under my jurisdiction and was completed on (mo/day/year) 10/4/84 and this record is true to the best of my knowledge and belief. Kansas

Water Well Contractor's License No. 215 This Water Well Record was completed on (mo/day/yr) 10/20/84

under the business name of Winter Well Drilling by (signature) Charles Winter

INSTRUCTIONS: Use typewriter or ball point pen, PLEASE PRESS FIRMLY and PRINT clearly. Please fill in blanks, underline or circle the correct answers. Send top three copies to Kansas Department of Health and Environment, Division of Environment, Environmental Geology Section, Topeka, KS 66620. Send one to WATER WELL OWNER and retain one for your records.