


1 LOCATION OF WATER WELL:	Fraction	Section Number	Township Number	Range Number
County: <u>Butler</u>	<u>NW 1/4 MW 1/4 NE 1/4</u>	<u>5</u>	T <u>29</u> S	R <u>3</u> EW

Distance and direction from nearest town or city street address of well if located within city?

2 WATER WELL OWNER:	Board of Agriculture, Division of Water Resources
RR#, St. Address, Box # :	Application Number:
City, State, ZIP Code :	

3 LOCATE WELL'S LOCATION WITH AN "X" IN SECTION BOX:	4 DEPTH OF COMPLETED WELL: <u>85</u> ft. ELEVATION: <u>70</u> ft.
--	---

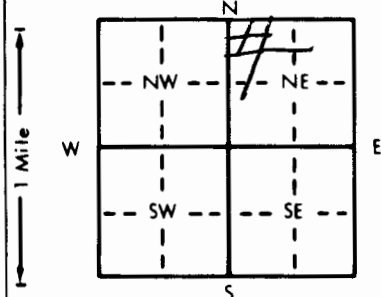

Depth(s) Groundwater Encountered	1. <u>30</u> ft.	2. <u>70</u> ft.	3. <u>85</u> ft.
WELL'S STATIC WATER LEVEL	<u>30</u> ft. below land surface measured on mo/day/yr		
Pump test data:	Well water was	ft. after	hours pumping
Est. Yield	<u>35</u> gpm	Well water was	ft. after
Bore Hole Diameter	<u>8 1/2</u> in.	to	ft., and
WELL WATER TO BE USED AS:	5 Public water supply	8 Air conditioning	11 Injection well
1 Domestic	3 Feedlot	6 Oil field water supply	9 Dewatering
2 Irrigation	4 Industrial	7 Lawn and garden only	10 Monitoring well
Was a chemical/bacteriological sample submitted to Department? Yes <u>X</u> No <u>X</u> If yes, mo/day/yr sample was submitted			
Water Well Disinfected? Yes <u>X</u> No <u>X</u>			

5 TYPE OF BLANK CASING USED:	5 Wrought iron	8 Concrete tile	CASING JOINTS: Glued <u>X</u> Clamped <u>X</u>
1 Steel	3 RMP (SR)	6 Asbestos-Cement	9 Other (specify below)
2 PVC	4 ABS	7 Fiberglass	10 Asbestos-cement
Blank casing diameter	<u>5</u> in.	to	ft., Dia
Casing height above land surface	<u>18</u> in.	weight	<u>160</u> lbs./ft.
TYPE OF SCREEN OR PERFORATION MATERIAL:	7 PVC	10 Asbestos-cement	12 None used (open hole)
1 Steel	3 Stainless steel	5 Fiberglass	8 RMP (SR)
2 Brass	4 Galvanized steel	6 Concrete tile	9 ABS
SCREEN OR PERFORATION OPENINGS ARE:	5 Gauzed wrapped	8 Saw cut	11 None (open hole)
1 Continuous slot	3 Mill slot	9 Drilled holes	10 Other (specify)
2 Louvered shutter	4 Key punched	7 Torch cut	

SCREEN-PERFORATED INTERVALS:	From <u>60</u> ft. to <u>85</u> ft.	From <u>85</u> ft. to <u>100</u> ft.	From <u>100</u> ft. to <u>124</u> ft.
GRAVEL PACK INTERVALS:	From <u>60</u> ft. to <u>85</u> ft.	From <u>85</u> ft. to <u>100</u> ft.	From <u>100</u> ft. to <u>124</u> ft.

6 GROUT MATERIAL:	1 Neat cement	2 Cement grout	3 Bentonite	4 Other
Grout Intervals:	From <u>0</u> ft. to <u>20</u> ft.	From <u>20</u> ft. to <u>85</u> ft.	From <u>85</u> ft. to <u>100</u> ft.	From <u>100</u> ft. to <u>124</u> ft.
What is the nearest source of possible contamination:	10 Livestock pens	14 Abandoned water well	11 Fuel storage	15 Oil well/Gas well
1 Septic tank	4 Lateral lines	7 Pit privy	12 Fertilizer storage	16 Other (specify below)
2 Sewer lines	5 Cess pool	8 Sewage lagoon	13 Insecticide storage	
3 Watertight sewer lines	6 Seepage pit	9 Feedyard		
Direction from well?	<u>5</u>	How many feet?	<u>100</u>	

FROM	TO	LITHOLOGIC LOG	FROM	TO	PLUGGING INTERVALS
<u>0</u>	<u>5</u>	<u>SOIL</u>			
<u>5</u>	<u>10</u>	<u>CLAY</u>			
<u>10</u>	<u>12</u>	<u>ROCK</u>			
<u>12</u>	<u>85</u>	<u>SHALE & LIME</u>			

7 CONTRACTOR'S OR LANDOWNER'S CERTIFICATION:	This water well was (1) constructed, (2) reconstructed, or (3) plugged under my jurisdiction and was completed on (mo/day/year) <u>6/12/94</u> and this record is true to the best of my knowledge and belief. Kansas Water Well Contractor's License No. <u>1254</u> This Water Well Record was completed on (mo/day/yr) <u>7/19/94</u> under the business name of <u>Winter Well Drill</u> by (signature) <u>Charles Winter</u>
--	---