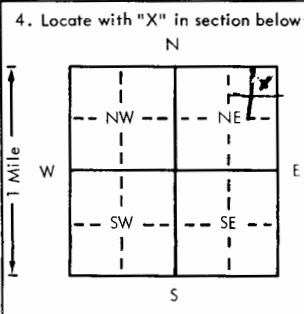


USE TYPEWRITER OR BALL
POINT PEN-PRESS FIRMLY,
PRINT CLEARLY.

WATER WELL RECORD
KSA 82a-1201-1215

Kansas Department of Health and
Environment-Division of Environment
(Water well Contractors)
Topeka, Kansas 66620

1. Location of well:		County Butler	Fraction NE 1/4 NE 1/4 NE 1/4	Section number 9	Township number T 29 S R 3 E	Range number 3
2. Distance and direction from nearest town or city: 1/2 mi. SE of Robe Hill			3. Owner of well: JIM BANNON R.R. or street: RR #2 City, state, zip code: Udell KS, 67146			
4. Locate with "X" in section below: 			6. Bore hole dia. 8.5 in. Completion date 2-13-77 Well depth 70 ft.			
5. Type and color of material			7. ☒ Cable tool ☐ Rotary ☐ Driven ☐ Dug ☐ Hollow rod ☐ Jetted ☐ Bored ☐ Reverse rotary			
Top Soil			8. Use: ☒ Domestic ☐ Public supply ☐ Industry ☐ Irrigation ☐ Air conditioning ☐ Stock ☐ Lawn ☐ Oil field water ☐ Other			
Clay yellow			9. Casing: Material PLS Height: Above or below Threaded ☐ Welded ☒ Surface 12 in. RMP ☒ PVC ☐ Weight ☐ lbs./ft. Dia. 5 in. to 70 ft. depth Wall Thickness: inches or Dia. ☐ in. to ☐ ft. depth Gage No. 1200			
Clay Light gray			10. Screen: Manufacturer's name SUNFLOWER MEG Type RMP Dia. 5" Slot/gauze 1/16 Length 10' Set between 60 ft. and 70 ft. Gravel pack? ☒ Size range of material 30-34			
Clay yellow			11. Static water level: ☐ mo./day/yr. 27 ft. below land surface Date 2-13-77			
Shale gray brown			12. Pumping level below land surfaces: NA ____ ft. after ____ hrs. pumping ____ g.p.m. ____ ft. after ____ hrs. pumping ____ g.p.m. Estimated maximum yield ____ g.p.m.			
Shale blue gray			13. Water sample submitted: ☐ Yes ☒ No Date ____			
(Water at 60')			14. Well head completion: ☐ Pitless adapter 12 inches above grade			
			15. Well grouted? YES With: ☐ Neat cement ☐ Bentonite ☒ Concrete Depth: From 10 ft. to 0 ft.			
			16. Nearest source of possible contamination: ft. 100 Direction N Type Lagoon Well disinfected upon completion? ☒ Yes ☐ No			
			17. Pump: ☒ Not installed Manufacturer's name ____ Model number ____ HP ____ Volts ____ Length of drop pipe ____ ft. capacity ____ g.p.m. Type: ☐ Submersible ☐ Turbine ☐ Jet ☐ Reciprocating ☐ Centrifugal ☐ Other			
18. Elevation:			20. Water well contractor's certification: This well was drilled under my jurisdiction and this report is true to the best of my knowledge and belief. Brady water wells 363 Business name R2 Dougless KS license No. ____ Address Richard Brady date 2-13-77 Signed Richard Brady Authorized representative			
19. Remarks: owner will install concrete slab at ground level.						

Forward the white, blue and pink copies to the Department of Health and Environment

Form WWC-5