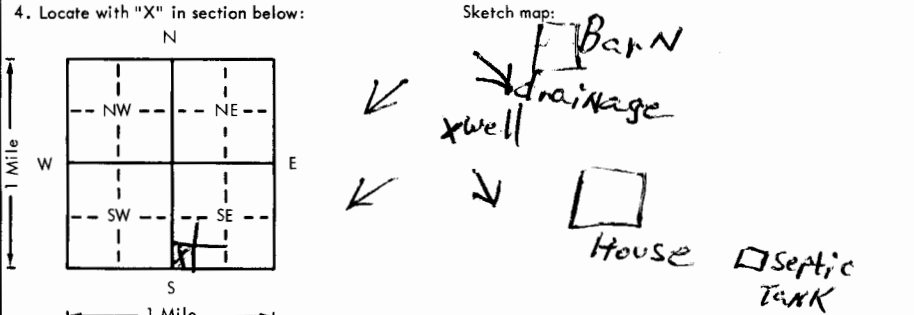


USE TYPEWRITER OR BALL
POINT PEN-PRESS FIRMLY,
PRINT CLEARLY.

WATER WELL RECORD
KSA 82a-1201-1215

Kansas Department of Health and
Environment-Division of Environment
(Water well Contractors)
Topeka, Kansas 66620

1. Location of well:		County <u>Butler</u>	Fraction <u>SW 1/4 SW 1/4 SE 1/4</u>	Section number <u>16</u>	Township number <u>T 29 S R 3</u>	Range number <u>E 4</u>
2. Distance and direction from nearest town or city: <u>5 miles west of Douglass Ks.</u> Street address of well location if in city:				3. Owner of well: <u>Garcia Williams</u> R.R. or street: <u>R #1</u> City, state, zip code: <u>Rose Hill Ks. 67133</u>		
4. Locate with "X" in section below: 				6. Bore hole dia. <u>9</u> in. Completion date <u>10-4-78</u> Well depth <u>70</u> ft.		
5. Type and color of material				7. ☒ Cable tool ☐ Rotary ☐ Driven ☐ Dug ☐ Hollow rod ☐ Jetted ☐ Bored ☐ Reverse rotary		
				8. Use: ☐ Domestic ☐ Public supply ☐ Industry ☐ Irrigation ☐ Air conditioning ☒ Stock ☐ Lawn ☐ Oil field water ☐ Other		
				9. Casing: Material <u>PLTS</u> Height: Above or below Threaded ☐ Welded ☒ Surface <u>12</u> in. RMP ☒ PVC ☐ Weight ☐ lbs./ft. Dia. <u>5</u> in. to <u>70</u> ft. depth Wall Thickness: inches or Dia. ☐ in. to ☐ ft. depth gauge No. <u>200</u>		
				10. Screen: Manufacturer's name <u>SUNFLOWER</u> <u>MLG INC.</u> Type <u>RMP</u> Dia. <u>5"</u> Slot/gauze <u>3/64</u> Length <u>10'</u> Set between <u>60</u> ft. and <u>70</u> ft. Gravel pack? ☒ Size range of material <u>14-24</u>		
				11. Static water level: <u>43</u> ft. below land surface Date <u>10-4-78</u>		
				12. Pumping level below land surfaces: <u>m</u> <u> </u> ft. after <u> </u> hrs. pumping <u> </u> g.p.m. <u> </u> ft. after <u> </u> hrs. pumping <u> </u> g.p.m. Estimated maximum yield <u> </u> g.p.m.		
				13. Water sample submitted: <u> </u> mo./day/yr. <u> </u> Yes ☒ No <u> </u> Date <u> </u>		
				14. Well head completion: <u> </u> <u> </u> Pitless adapter <u>12</u> inches above grade		
				15. Well grouted? <u>YES</u> With: <u> </u> Neat cement <u> </u> Bentonite ☒ Concrete <u> </u> Depth: From <u>10</u> ft. to <u>0</u> ft.		
				16. Nearest source of possible contamination: ft. <u>100</u> Direction <u>N</u> Type <u>BARN</u> Well disinfected upon completion? ☒ Yes ☐ No		
				17. Pump: ☒ Not installed Manufacturer's name <u> </u> Model number <u> </u> HP <u> </u> Volts <u> </u> Length of drop pipe <u> </u> ft. capacity <u> </u> g.p.m. Type: <u> </u> Submersible <u> </u> Turbine <u> </u> Jet <u> </u> Reciprocating <u> </u> Centrifugal <u> </u> Other		
(Use a second sheet if needed)						
18. Elevation:		19. Remarks:				
Topography: ☐ Hill ☒ Slope ☐ Upland ☐ Valley		20. Water well contractor's certification: This well was drilled under my jurisdiction and this report is true to the best of my knowledge and belief. <u>Braddy Water wells</u> <u>363</u> Business name License No. Address <u>Box 217A Douglass Ks</u> Signed <u>Richard Braddy</u> Date <u>10-4-78</u> Authorized representative				

Forward the white, blue and pink copies to the Department of Health and Environment

Form WWC-5