#3 - EAST OF HOUSE

WATER WELL RECORD Form WWC-5 KSA 82a-1212

1 LOCATION OF WATER WELL: County: BUTLER	Fraction: NW ¼ SE ¼ SE ¼	Section Number: 29	Township Number: T 29 S	Range Number: R 3 E/W

Distance and direction from nearest town or city street address of well if located within city? 4 M-S - ROSE HILL RD-1 M-E -

2 WATER WELL OWNER: DORIS LANGLEY
RR#, St. Address, Box # : RR 1 BOX 103
City, State, ZIP Code : DOUGLASS KS 67039

Board of Agriculture, Division of Water Resources Application Number:

3 LOCATE WELL'S LOCATION WITH AN "X" IN SECTION BOX:

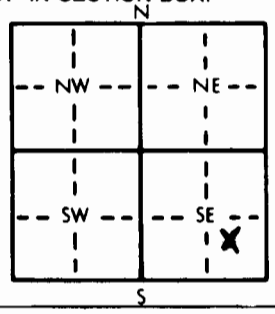

4 DEPTH OF COMPLETED WELL * 60 ft. ELEVATION: —
Depth(s) Groundwater Encountered 1. DRY ft. 2. — ft. 3. — ft.
WELL'S STATIC WATER LEVEL NA ft. below land surface measured on mo/day/yr
Pump test data: Well water was — ft. after — hours pumping — gpm
Est. Yield — gpm: Well water was — ft. after — hours pumping — gpm
Bore Hole Diameter 8.625 in. to TD ft., and — in. to — ft.
WELL WATER TO BE USED AS: 1 Domestic 2 Irrigation 3 Feedlot 4 Industrial 5 Public water supply 6 Oil field water supply 7 Lawn and garden only 8 Air conditioning 9 Dewatering 10 Monitoring well 11 Injection well 12 Other (Specify below) PLUGGED
Was a chemical/bacteriological sample submitted to Department? Yes — No X; If yes, mo/day/yr sample was submitted —
Water Well Disinfected? Yes X No —

5 TYPE OF BLANK CASING USED: 1 Steel 2 PVC 3 RMP (SR) 4 ABS 5 Wrought iron 6 Asbestos-Cement 7 Fiberglass 8 Concrete tile 9 Other (specify below) OPEN HOLE
CASING JOINTS: Glued — Clamped — Welded — Threaded —
Blank casing diameter NA in. to — ft., Dia — in. to — ft., Dia — in. to — ft.
Casing height above land surface NA in., weight — lbs./ft. Wall thickness or gauge No. —
TYPE OF SCREEN OR PERFORATION MATERIAL: NA
1 Steel 2 Brass 3 Stainless steel 4 Galvanized steel 5 Fiberglass 6 Concrete tile 7 PVC 8 RMP (SR) 9 ABS 10 Asbestos-cement 11 Other (specify) — 12 None used (open hole)
SCREEN OR PERFORATION OPENINGS ARE: NA
1 Continuous slot 2 Louvered shutter 3 Mill slot 4 Key punched 5 Gauzed wrapped 6 Wire wrapped 7 Torch cut 8 Saw cut 9 Drilled holes 10 Other (specify) — 11 None (open hole)
SCREEN-PERFORATED INTERVALS: From NA ft. to — ft., From — ft. to — ft.
From — ft. to — ft., From — ft. to — ft.
X SAND ~~GRAVEL~~ PACK INTERVALS: From GL-14 ft. to APROX 50 ft., From — ft. to — ft.
From ft. to ft., From ft. to ft.

6 GROUT MATERIAL: 1 Neat cement 2 Cement grout X 3 Bentonite 4 Other —
Grout Intervals: X From 3.5 ft. to 10 ft., From — ft. to — ft., From — ft. to — ft.
What is the nearest source of possible contamination:
1 Septic tank 2 Sewer lines 3 Watertight sewer lines 4 Lateral lines 5 Cess pool 6 Seepage pit 7 Pit privy 8 Sewage lagoon 9 Feedyard 10 Livestock pens 11 Fuel storage 12 Fertilizer storage 13 Insecticide storage 14 Abandoned water well 15 Oil well/Gas well 16 Other (specify below) CLEAN AREA
Direction from well? — How many feet? —

FROM	TO	LITHOLOGIC LOG	FROM	TO	PLUGGING INTERVALS
		* NO RECORDS - DRY OPEN HOLE			
		THOUGHT TO BE 60-65' DEEP - AT TIME			
		OF PLUGGING IT HAD 8-10' OF WATER			
		WITH OBSTRUCTIONS - OBSTRUCTION			
		FELL TO BOTTOM WHEN TRYING TO REMOVE.			
		15 GAL OF BENTONITE SLURY DOWN HOLE.			
		TOP SOIL REMOVED TO - 4' - BENTONITE			
		ADDED THEN BACK FILLED.			
			60	10	Clay
			10	3.5	Bentonite
			3.5	0	Clay

7 CONTRACTOR'S OR LANDOWNER'S CERTIFICATION: This water well was (1) constructed, (2) reconstructed, or (3) plugged under my jurisdiction and was completed on (mo/day/year) 05-09-94 and this record is true to the best of my knowledge and belief. Kansas Water Well Contractor's License No. 479 This Water Well Record was completed on (mo/day/yr) 05-16-94 under the business name of EBBERTS DRILLING by (signature) [signature]

INSTRUCTIONS: Use typewriter or ball point pen. *PLEASE PRESS FIRMLY* and *PRINT* clearly. Please fill in blanks, underline or circle the correct answers. Send top three copies to Kansas Department of Health and Environment, Bureau of Water, Topeka, Kansas 66620-0001. Telephone: 913-296-5545. Send one to WATER WELL OWNER and retain one for your records.