


1 LOCATION OF WATER WELL: County: BUTLER		Fraction $\frac{1}{4}$ NW $\frac{1}{4}$ SW $\frac{1}{4}$	Section Number 10	Township Number T 29 S	Range Number R 4 E/W
--	--	---	-----------------------------	----------------------------------	--------------------------------

Distance and direction from nearest town or city street address of well if located within city?
ONE MILE NORTH, 1/4 MILE EAST OF DOUGLASS, KS

2 WATER WELL OWNER:	BOB JOHNSON	Board of Agriculture, Division of Water Resources
RR#, St. Address, Box # :	Rr 2	Application Number:
City, State, ZIP Code :	DOUBLASS, KS 67039	

3. LOCATE WELL'S LOCATION WITH AN "X" IN SECTION BOX: 4. DEPTH OF COMPLETED WELL: 60 ft. ELEVATION: _____
Depth(s) Groundwater Encountered 1. 40 ft. 2. _____ ft. 3. _____ ft.

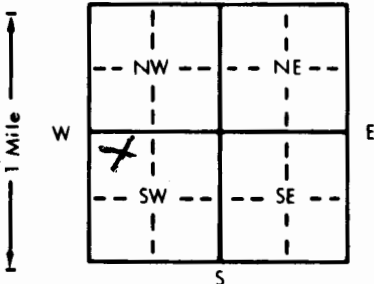

4 DEPTH OF COMPLETED WELL 60 ft. ELEVATION: _____

Depth(s) Groundwater Encountered 1. 40 ft. 2. _____ ft. 3. _____ ft.

WELL'S STATIC WATER LEVEL 25 ft. below land surface measured on mo/day/yr _____

Pump test data: Well water was _____ ft. after _____ hours pumping _____ gpm

Est. Yield _____ gpm: Well water was _____ ft. after _____ hours pumping _____ gpm

Bore Hole Diameter 8 in. to 60 ft., and _____ in. to _____ ft.

WELL WATER TO BE USED AS:

1 Domestic	3 Feedlot	6 Oil field water supply	8 Air conditioning	11 Injection well
2 Irrigation	4 Industrial	7 Lawn and garden only	9 Dewatering	12 Other (Specify below)
			10 Observation well	

Was a chemical/bacteriological sample submitted to Department? Yes _____ No ☒ If yes, mo/day/yr sample was submitted _____

Water Well Disinfected? Yes ☒ No _____

5 TYPE OF BLANK CASING USED:	5 Wrought iron	8 Concrete tile	CASING JOINTS: <u>Glued</u> Clamped
1 Steel	6 Asbestos-Cement	9 Other (specify below)	Welded
<u>2 PVC</u>	7 Fiberglass		Threaded
3 RMP (SR)			
4 ABS			

Blank casing diameter . . . 5 . . . in. to 61 . . . ft., Dia . . . in. to . . . ft., Dia . . . in. to . . . ft.
Casing height above land surface . . . +12 . . . in., weight . . . 160 . . . lbs./ft. Wall thickness or gauge No.

TYPE OF SCREEN OR PERFORATION MATERIAL:

1 Steel	3 Stainless steel	5 Fiberglass	7 PVC	10 Asbestos-cement
2 Brass	4 Galvanized steel	6 Concrete tile	8 RMP (SR)	11 Other (specify)
			9 ABS	12 None used (open hole)

SCREEN OR PERFORATION OPENINGS ARE:

1 Continuous slot	3 Mill slot	5 Gauzed wrapped	8 Saw cut	11 None (open hole)
2 Louvered shutter	4 Key punched	6 Wire wrapped	9 Drilled holes	
		7 Torch cut	10 Other (specify)	

SCREEN-PERFORATED INTERVALS: From 40 ft. to 60 ft., From ft. to ft.
From ft. to ft., From ft. to ft.
GRAVEL PACK INTERVALS: From 20 ft. to 60 ft., From ft. to ft.

From ft. to ft., From ft. to ft.

6 GROUT MATERIAL: 1 Neat cement 2 Cement grout 3 Bentonite 4 Other

Grout Intervals: From 3 ft. to 20 ft., From ft. to ft., From ft. to ft.

What is the nearest source of possible contamination:

1 Septic tank	4 Lateral lines	7 Pit privy	10 Livestock pens	14 Abandoned water well
2 Sewer lines	5 Cess pool	8 Sewage lagoon	11 Fuel storage	15 Oil well/Gas well
3 Watertight sewer lines	6 Seepage pit	9 Feedyard	12 Fertilizer storage	16 Other (specify below)

Direction from well? **EAST**

How many feet? **500**

FROM	TO	LITHOLOGIC LOG	FROM	TO	LITHOLOGIC LOG
0'	5'	EARTH			
5'	13'	RED BED			
13'	19'	LIGHT GRAY CLAY			
19'	25'	LIGHT BROWN CLAY			
25'	43'	DARK BROWN CLAY water			
43'	55'	LIGHT GRAY			
55'	60'	DARK GRAY SHAPE			

7 CONTRACTOR'S OR LANDOWNER'S CERTIFICATION: This water well was (1) constructed, (2) reconstructed, or (3) plugged under my jurisdiction and was completed on (mo/day/year) April 10, 1983 and this record is true to the best of my knowledge and belief. Kansas

Water Well Contractor's License No. 424 This Water Well Record was completed on (mo/day/yr) May 31 1983
under the business name of REISCHER WELL DRILLING by (signature) Jerry Reischer, BYD
INSTRUCTIONS: Use typewriter or ball point pen, PLEASE PRESS FIRMLY and PRINT clearly. Please fill in blanks, underline or circle the correct answers. Send top
three copies to Kansas Department of Health and Environment, Division of Environment, Environmental Geology Section, Topeka, KS 66620. Send one to WATER WELL
OWNER and retain one for your records.