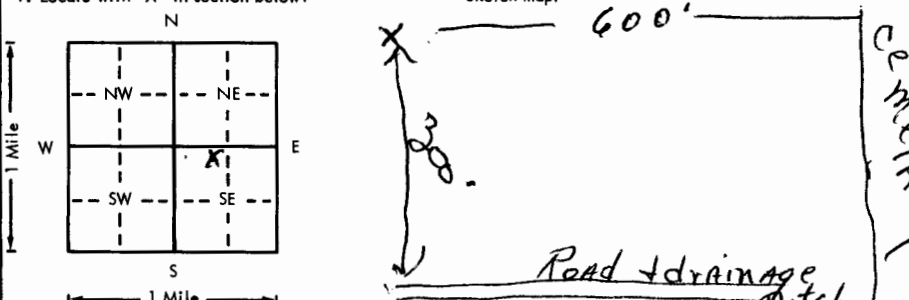


USE TYPEWRITER OR BALL
POINT PEN-PRESS FIRMLY,
PRINT CLEARLY.

WATER WELL RECORD
KSA 82a-1201-1215

Kansas Department of Health and
Environment-Division of Environment
(Water well Contractors)
Topeka, Kansas 66620

1. Location of well:	County Butler	Fraction NE 1/4 NW 1/4 SE 1/4	Section number 21 295	Township number T 29 S	Range number R 4 E
2. Distance and direction from nearest town or city: Street address of well location if in city: 1 mi E Douglas			3. Owner of well: Bob Wright R.R. or street: City, state, zip code: Atlanta, KS, 67008		
4. Locate with "X" in section below: 			6. Bore hole dia. 8 in. Completion date 7-25-76 Well depth 117 ft.		
5. Type and color of material			7. Cable tool ☒ Rotary ☐ Driven ☐ Dug ☐ Hollow rod ☐ Jetted ☐ Bored ☐ Reverse rotary		
Original depth of well 50'			8. Use: ☒ Domestic ☐ Public supply ☐ Industry ☐ Irrigation ☐ Air conditioning ☐ Stock ☐ Lawn ☐ Oil field water ☐ Other		
Shale - green - yellow 50 64			9. Casing: Material PVC Height: Above or below Threaded ☐ Welded ☐ Surface 24 in. RMP ☐ PVC ☒ Weight ☐ lbs./ft. Dia. 6 in. to 117 ft. depth Wall Thickness ☐ inches or Dia. ☐ in. to ☐ ft. depth gage No. 14		
Red Rock 64 86			10. Screen: Manufacturer's name Al-L Type Slot Dia. 6" Slot/gauze 1/8 Length 40' Set between 80-117 ft. and ☐ ft. ☐ ft. and ☐ ft.		
Shale - grey 86 98			11. Static water level: ☐ mo./day/yr. 40 ft. below land surface Date 7-25-76		
Lime - yellow 98 104			12. Pumping level below land surfaces: No pump ☐ ft. after ☐ hrs. pumping ☐ g.p.m. ☐ ft. after ☐ hrs. pumping Set g.p.m.		
Shale - blue 104 112			Estimated maximum yield 10 g.p.m.		
Lime - grey 112 117			13. Water sample submitted: ☐ mo./day/yr. ☒ Yes ☒ No Date ☐		
T.D. - 117'			14. Well head completion: ☐ Pitless adapter 24 inches above grade		
			15. Well grouted? Yes With: Neat cement Bentonite ☐ Concrete ☐ Depth: From 3 ft. to 20 ft.		
			16. Nearest source of possible contamination: ft. ☐ Direction ☐ Type ☐ Well disinfected upon completion? ☒ Yes ☐ No		
No electricity or any construction done at time well was completed. Pump to be set at later date. Owner understands requirements & agrees to submit to SE 1/4			17. Pump: ☒ Not installed Manufacturer's name ☐ Model number ☐ HP ☐ Volts ☐ Length of drop pipe ☐ ft. capacity ☐ g.p.m. Type: ☐ Submersible ☐ Turbine ☐ Jet ☐ Reciprocating ☐ Centrifugal ☐ Other		
18. Elevation: 300			20. Water well contractor's certification: This well was drilled under my jurisdiction and this report is true to the best of my knowledge and belief. Bailey Drilling Co 209 Business name License No. Address Burden, Kans. 67019 Signed Donald Bailey Date 8-2-76 Authorized representative		

Forward the white, blue and pink copies to the Department of Health and Environment

Form WWC-5