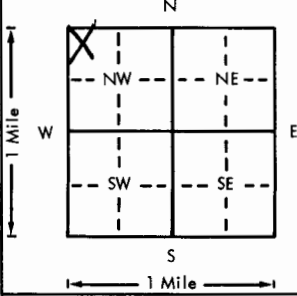
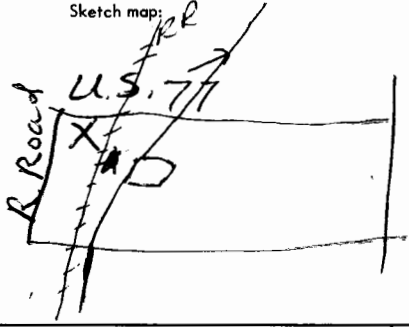


USE TYPEWRITER OR BALL
POINT PEN-PRESS FIRMLY,
PRINT CLEARLY.

WATER WELL RECORD
KSA 82a-1201-1215

Kansas Department of Health and
Environment-Division of Environment
(Water well Contractors)
Topeka, Kansas 66620

1. Location of well:		County Butler	Fraction NW 1/4 NW 1/4 NW 1/4	Section number 21	Township number T 29 S R 4 EW	Range number
2. Distance and direction from nearest town or city: Street address of well location if in city:		Douglas 9084 Curlew		3. Owner of well: Dale Packham R.R. or street: 214 N Forrest City, state, zip code: Douglas KS		
4. Locate with "X" in section below:		Sketch map:		6. Bore hole dia. 8 in. Completion date 9/8/77 Well depth 50 ft.		
				7. ☒ Cable tool ☒ Rotary ☐ Driven ☐ Dug ☐ Hollow rod ☐ Jetted ☐ Bored ☐ Reverse rotary		
5. Type and color of material		From		To		8. Use: ☒ Domestic ☐ Public supply ☐ Industry ☒ Irrigation ☐ Air conditioning ☐ Stock ☐ Lawn ☐ Oil field water ☐ Other
Red Clay		0		28		9. Casing: Material styrofoam Height: Above or below Threaded ☐ Welded ☐ Surface 12 in. RMP ☐ PVC ☐ Weight 200 lbs./ft. Dia. 5 in. to 50 ft. depth Wall Thickness: inches or Dia. ☐ in. to ☐ ft. depth gage No. ☐
Brown + Black Shale		28		50		10. Screen: Manufacturer's name Sunflower Type 200 Dia. 5 Slot/ gauze shot Length 30 Set between 30 ft. and 50 ft. ft. and ☐ ft. Gravel pack? yes Size range of material 1/4
						11. Static water level: 28 ft. below land surface Date 9/8/77
						12. Pumping level below land surfaces: ft. after ☐ hrs. pumping ☐ g.p.m. ft. after ☐ hrs. pumping ☐ g.p.m. Estimated maximum yield 3 g.p.m.
						13. Water sample submitted: ☐ Yes ☒ No Date ☐
						14. Well head completion: ☐ Pitless adapter 12 Inches above grade
						15. Well grouted? yes With: ☒ Neat cement ☐ Bentonite ☐ Concrete Depth: From 0 ft. to 10 ft.
						16. Nearest source of possible contamination: ft. 30 Direction South Type Sewer Well disinfected upon completion? ☒ Yes ☐ No
						17. Pump: ☒ Not installed Manufacturer's name ☐ Model number ☐ HP ☐ Volts ☐ Length of drop pipe ☐ ft. capacity ☐ g.p.m. Type: ☐ Submersible ☐ Turbine ☐ Jet ☐ Reciprocating ☐ Centrifugal ☐ Other
						(Use a second sheet if needed)
18. Elevation:		19. Remarks:		20. Water well contractor's certification: This well was drilled under my jurisdiction and this report is true to the best of my knowledge and belief. Jet Drilling 313 Business name 252 N Sakin License No. 252 Address Wright Sandberg Date 9/8/77 Signed Wright Sandberg Authorized representative		

Forward the white, blue and pink copies to the Department of Health and Environment

Form WWC-5