

1 LOCATION OF WATER WELL: County: <u>Butler</u>	Fraction: <u>NW 1/4 NW 1/4 SE 1/4</u>	Section Number: <u>26</u>	Township Number: <u>T 29 S</u>	Range Number: <u>R 4 E</u>
--	---------------------------------------	---------------------------	--------------------------------	----------------------------

Distance and direction from nearest town or city street address of well if located within city?


~~2 1/2~~ 2 1/2 E 1/2 S of Douglass

2 WATER WELL OWNER: Mike Flannagan
RR#, St. Address, Box #
City, State, ZIP Code Douglas Kan

3 LOCATE WELL'S LOCATION WITH AN "X" IN SECTION BOX: 4 DEPTH OF COMPLETED WELL: 100 ft. ELEVATION: 80

Depth(s) Groundwater Encountered, 1. 50 ft. 2. 50 ft. 3. 50 ft.

WELL'S STATIC WATER LEVEL 50 ft. below land surface measured on mo/day/yr

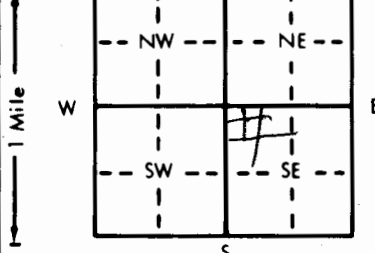

Depth(s) Groundwater Encountered: 1. 50 ft. 2. _____ ft. 3. _____ ft.
WELL'S STATIC WATER LEVEL: _____ ft. below land surface measured on mo/day/yr _____

Pump test data: Well water was ft. after hours pumping gpm

Est. Yield 2 gpm: Well water was _____ ft. after _____ hours pumping _____ gpm

WEI WATER TO BE USED AS: 5 Public water supply 8 Air conditioning 11 Injection well

1 Domestic	3 Feedlot	6 Oil field water supply	9 Dewatering	12 Other (Specify below)
------------	-----------	--------------------------	--------------	--------------------------

2 Irrigation 4 Industrial 7 Lawn and garden only 10 Observation well

Was a chemical/bacteriological sample submitted to Department? Yes.....(No.....); If yes, mo/day/yr sample was submitted

5	TYPE OF BLANK CASING USED:	5 Wrought iron	8 Concrete tile	CASING JOINTS: Glued ☒ Clamped ☐
---	----------------------------	----------------	-----------------	---

1 Steel 3 RMP (SR) 6 Asbestos-Cement 9 Other (specify below) Welded

Blank casing diameter 2 PVC 4 ABS 7 Fiberglass Threaded.

Casing height above land surface. 18 in., weight 200 lbs./ft. Wall thickness or gauge No. 24

TYPE OF SCREEN OR PERFORATION MATERIAL: 7 PVC 10 Asbestos-cement

1 Steel	3 Stainless steel	5 Fiberglass	8 RMP (SR)	11 Other (specify)
2 Brass	4 Galvanized steel	6 Concrete tile	9 ABS	12 None used (open hole)

SCREEN OR PERFORATION OPENINGS ARE: 5 Gauzed wrapped 8 Saw cut 11 None (open hole)

1 Continuous slot	3 Mill slot	6 Wire wrapped	9 Drilled holes
-------------------	-------------	----------------	-----------------

2 Louvered shutter 4 Key punched 7 Torch cut 10 Other (specify)

SCREEN PERFORATED INTERVALS: From 70 # to 90 # From # to #


GRAVEL PACK INTERVALS: From ft. to ft., From ft. to ft.

		From		ft. to		ft., From		ft. to		ft.	

6) GROUT MATERIAL: 1 Neat cement 2 Cement grout 3 Bentonite 4 Other

Grout Intervals: From 0 ft. to 13 ft. From ft. to ft. From ft. to ft.

What is the nearest source of possible contamination:	10 Livestock pens	14 Abandoned water well
---	-------------------	-------------------------

1 Septic tank	4 Lateral lines	7 Pit privy	11 Fuel storage	15 Oil well/Gas well

2 Sewer lines	5 Cess pool	8 Sewage lagoon	12 Fertilizer storage	16 Other (specify below)
3 Watertight sewer lines	6 Seepage pit	9 Feedyard	13 Insecticide storage	

Direction from well? S How many feet? 150

FROM	TO	LITHOLOGIC LOG	FROM	TO	LITHOLOGIC LOG
3	4	5.1			

0	7	50%			
4	20	Char			

20	35	5/10/1e			
----	----	---------	--	--	--

35	foo	Line			
----	-----	------	--	--	--

[illegible][illegible][illegible]

--	--	--	--	--	--

[illegible][illegible][illegible][illegible]

7 CONTRACTOR'S OR LANDOWNER'S CERTIFICATION: This water well was (1) constructed, (2) reconstructed, or (3) plugged under my jurisdiction and was


Water Well Contractor's License No. 2 This Water Well Record was completed on (mo/day/y) 12/1/81
under the business name of Winter Well Drilling by (signature) Barbara Winter

INSTRUCTIONS: Use typewriter or ball point pen, **PLEASE PRESS FIRMLY** and **PRINT** clearly. Please fill in blanks, underline or circle the correct answers. Send top

three copies to Kansas Department of Health and Environment, Division of Environment, Environmental Geology Section, Topeka, KS 66620. Send one to WATER WELL OWNER and retain one for your records.