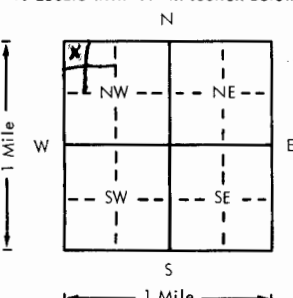
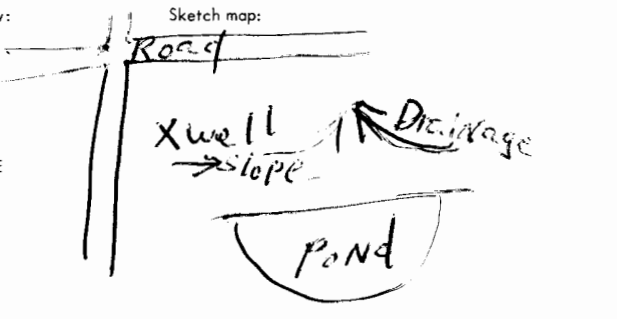


USE TYPEWRITER OR BALL
POINT PEN-PRESS FIRMLY,
PRINT CLEARLY.

WATER WELL RECORD
KSA 82a-1201-1215

Kansas Department of Health and
Environment-Division of Environment
(Water well Contractors)
Topeka, Kansas 66620

1. Location of well:		County Butler	Fraction NW 1/4 NW 1/4 NW 1/4	Section number 17	Township number T 29	Range number S R 5	E/W
2. Distance and direction from nearest town or city: SE 1 N of Douglass KS				3. Owner of well: Ed Weishaar R.R. or street: R#1 City, state, zip code: Douglass KS 67037			
4. Locate with "X" in section below:				Sketch map:			
							
5. Type and color of material				From	To	6. Bore hole dia. 8.5 in. Completion date 11-2-78 Well depth 55 ft.	
Top Soil				0	1	7. ☒ Cable tool ☐ Rotary ☐ Driven ☐ Dug ☐ Hollow rod ☐ Jetted ☐ Bored ☐ Reverse rotary	
Clay Redish brown				1	4	8. Use: ☐ Domestic ☐ Public supply ☐ Industry ☐ Irrigation ☐ Air conditioning ☒ Stock ☐ Lawn ☐ Oil field water ☐ Other	
Clay yellow				4	13	9. Casing: Material PITS Height Above or below Threaded ☐ Welded ☒ Surface 12 in. RMP ☒ PVC ☐ Weight ☐ lbs./ft. Dia. 5 in. to 55 ft. depth Wall Thickness: inches or Dia. ☐ in. to ☐ ft. depth gage No. 200	
Limestone yellow				13	22	10. Screen: Manufacturer's name SENECA MEG INC. Type RMP Dia. 5 1/2 Slot/gauze 1/16 Length 10' Set between 45 ft. and 55 ft. Gravel pack? No Size range of material	
(water at 22 ft.)						11. Static water level: ☐ mo./day/yr. 12 ft. below land surface Date 11-2-78	
Limestone light gray				22	47	12. Pumping level below land surfaces: NA ft. after hrs. pumping g.p.m. ft. after hrs. pumping g.p.m. Estimated maximum yield g.p.m.	
Shale blue gray				47	55	13. Water sample submitted: ☐ Yes ☒ No Date	
						14. Well head completion: ☐ Pitless adapter 12 inches above grade	
						15. Well grouted? yes With: ☐ Neat cement ☐ Bentonite ☒ Concrete Depth: From 13 ft. to 3 ft.	
						16. Nearest source of possible contamination: ft. 100 Direction SE Type pond Well disinfected upon completion? ☒ Yes ☐ No	
						17. Pump: ☒ Not installed Manufacturer's name Model number HP Volts Length of drop pipe ft. capacity g.p.m. Type: ☐ Submersible ☐ Turbine ☐ Jet ☐ Reciprocating ☐ Centrifugal ☐ Other	
(Use a second sheet if needed)							
18. Elevation:		19. Remarks:		20. Water well contractor's certification: This well was drilled under my jurisdiction and this report is true to the best of my knowledge and belief. Braddy Waterwells 363 Business name License No. Address R#1 Box 217A Douglass KS Signed Richard Braddy Date 11-2-78 Authorized representative			
Topography: ☐ Hill ☒ Slope ☐ Upland ☐ Valley							

Forward the white, blue and pink copies to the Department of Health and Environment

Form WWC-5