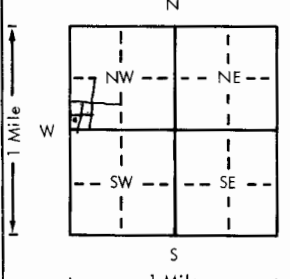
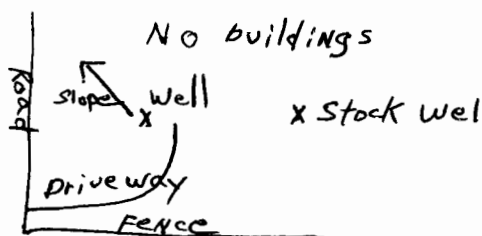


USE TYPEWRITER OR BALL
POINT PEN-PRESS FIRMLY,
PRINT CLEARLY.

WATER WELL RECORD
KSA 82a-1201-1215

Kansas Department of Health and
Environment-Division of Environment
(Water well Contractors)
Topeka, Kansas 66620

1. Location of well: County <u>Butler</u>		Fraction <u>SW 1/4 SW 1/4 NW 1/4</u>	Section number <u>21</u>	Township number <u>29</u>	Range number <u>5</u> <u>EW</u>
2. Distance and direction from nearest town or city: <u>1 1/2 S of Smileyville</u> Street address of well location if in city:			3. Owner of well: <u>Doyle High</u> R.R. or street: <u>R #2</u> City, state, zip code: <u>Douglass KS</u>		
4. Locate with "X" in section below: 		Sketch map: 		6. Bore hole dia. <u>8.5</u> in. Completion date <u>5-11-78</u> Well depth <u>99</u> ft.	
5. Type and color of material		From	To	7. ☒ Cable tool ☐ Rotary ☐ Driven ☐ Dug ☐ Hollow rod ☐ Jetted ☐ Bored ☐ Reverse rotary	
		8. Use: ☒ Domestic ☐ Public supply ☐ Industry ☐ Irrigation ☐ Air conditioning ☐ Stock ☐ Lawn ☐ Oil field water ☐ Other			
		9. Casing: Material <u>RMP</u> Height: Above or below Threaded ☐ Welded ☒ Surface <u>18</u> in. RMP ☒ PVC ☐ Weight <u>91</u> lbs./ft. Dia. <u>5</u> in. to <u>99</u> ft. depth Wall Thickness: inches or Dia. <u>5</u> in. to <u>99</u> ft. depth gage No. <u>20</u>			
		10. Screen: Manufacturer's name <u>SUNFLOWER</u> <u>Plastic Pipe Inc</u> Type <u>RMP</u> Dia. <u>5 IN</u> Slot/gauze <u>1/16</u> Length <u>20 FT</u> Set between <u>79</u> ft. and <u>99</u> ft. Gravel pack? <u>No</u> Size range of material			
		11. Static water level: <u>8.5</u> ft. below land surface Date <u>5-11-78</u> mo./day/yr.			
12. Pumping level below land surfaces: <u>NA</u> ft. after <u> </u> hrs. pumping <u> </u> g.p.m. ft. after <u> </u> hrs. pumping <u> </u> g.p.m. Estimated maximum yield <u> </u> g.p.m.		13. Water sample submitted: <u> </u> mo./day/yr. <u> </u> Yes ☒ No ☐ Date <u> </u>			
14. Well head completion: <u>18</u> inches above grade <u> </u> Pitless adapter		15. Well grouted? <u>yes</u> With: <u> </u> Neat cement <u> </u> Bentonite ☒ Concrete Depth: From <u>14</u> ft. to <u>4</u> ft.			
16. Nearest source of possible contamination: ft. <u>100</u> Direction <u>E</u> Type <u>stock well</u> Well disinfected upon completion? ☒ Yes ☐ No		17. Pump: ☒ Not installed Manufacturer's name <u> </u> Model number <u> </u> HP <u> </u> Volts <u> </u> Length of drop pipe <u> </u> ft. capacity <u> </u> g.p.m. Type: <u> </u> Submersible <u> </u> Turbine <u> </u> Jet <u> </u> Reciprocating <u> </u> Centrifugal <u> </u> Other			
18. Elevation: Topography: ☒ Hill ☒ Slope ☐ Upland ☐ Valley		19. Remarks: <u>Concrete skb to be installed by customer.</u>		20. Water well contractor's certification: This well was drilled under my jurisdiction and this report is true to the best of my knowledge and belief. <u>Braddy Water Wells</u> Business name <u> </u> License No. <u> </u> Address <u>R2 Douglass KS 363</u> Signed <u>Richard Braddy</u> Date <u>5-12-78</u> Authorized representative	

Forward the white, blue and pink copies to the Department of Health and Environment

Form WWC-5