5-31-77

USE TYPEWRITER OR BALL POINT PEN-PRESS FIRMLY, PRINT CLEARLY.

WATER WELL RECORD
KSA 82a-1201-1215

Kansas Department of Health and Environment-Division of Environment
(Water well Contractors)
Topeka, Kansas 66620

1. Location of well:	County	Fraction	Section number	Township number	Range number
	Butler	NW 1/4 SW 1/4 NW 1/4	21	T 29 S	R 6 E E/W

2. Distance and direction from nearest town or city: 1½ miles SW of Latham

Street address of well location if in city:

3. Owner of well: Mike Price

R.R. or street:

City, state, zip code: Latham, Kansas 67072

4. Locate with "X" in section below:

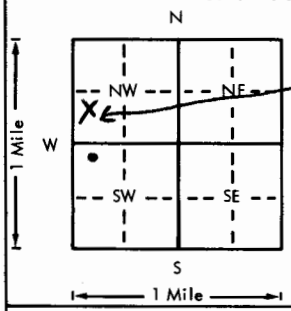

Sketch map:

6. Bore hole dia. 35 in. Completion date 12-15-76
Well depth 10 ft.

7. X Cable tool __ Rotary __ Driven __ Dug
__ Hollow rod __ Jetted __ Bored __ Reverse rotary

8. Use: X Domestic __ Public supply __ Industry
__ Irrigation __ Air conditioning __ Stock
__ Lawn __ Oil field water __ Other

9. Casing: Material RMP Height: Above or below
Threaded __ Welded __ Surface 12 in.
RMP X PVC __ Weight 1.55 lbs./ft.
Dia. 6 in. to 35 ft. depth Wall Thickness: inches or
Dia. __ in. to __ ft. depth gage No. .250 mwc

10. Screen: Manufacturer's name Sunflower
Type RMP Dia. 6"
Slot/gauze 1/16" Length 10'
Set between 25 ft. and 35 ft.
__ ft. and __ ft.
Gravel pack? NO Size range of material

11. Static water level: mo./day/yr.
18 ft. below land surface Date 12-10-76

12. Pumping level below land surfaces:
33 ft. after __ hrs. pumping 10 g.p.m.
__ ft. after __ hrs. pumping __ g.p.m.
Estimated maximum yield __ g.p.m.

13. Water sample submitted: mo./day/yr.
__ Yes X No Date

14. Well head completion: NO
X Pitless adapter __ Inches above grade

15. Well grouted? NO
With: __ Neat cement __ Bentonite __ Concrete
Depth: From __ ft. to __ ft.

16. Nearest source of possible contamination:
ft. 250 Direction West Type Ditch
Well disinfected upon completion? X Yes __ No

17. Pump: __ Not installed
Manufacturer's name Myers
Model number 52652-5A HP 1/2 Volts 230
Length of drop pipe 32 ft. capacity 8 g.p.m.
Type:
X Submersible __ Turbine
__ Jet __ Reciprocating
__ Centrifugal __ Other

5. Type and color of material	From	To
Top Soil	0'	3'
Red clay	3'	10'
Red clay & small gravel	10'	23'
Flint gravel 1"	23'	31'
Blue schale	31'	35'
Cream colored limestone	35'	

(Use a second sheet if needed)

18. Elevation:

Topography:
__ Hill
X Slope
__ Upland
__ Valley

19. Remarks: Grout to be done by landowner

20. Water well contractor's certification:
This well was drilled under my jurisdiction and this report is true to the best of my knowledge and belief.
Business name EASTMAN Drilling License No. 299
Address Box 115 Winfield
Signed Dale Eastman Date 12-30-76
Authorized representative

29 — 6 E W
21 NW SW NW
T R Sec 1/4 1/4 1/4

Forward the white, blue and pink copies to the Department of Health and Environment

Form WWC-5

MI-1023