

WATER WELL PLUGGING RECORD Form WWC-5P

KSA 82a-1212

ID NO.

1 LOCATION OF WATER WELL: Fraction nw 1/4 se 1/4 nw 1/4 Section Number 15 Township Number T 29 S Range Number 8 E W
 County: Elk

Street/Rural Address of Well Location; if unknown, distance & direction from nearest town or intersection: If at owner's address, check here 21114 SE Summit RD


Global Positioning Systems (GPS) information:

Latitude: _____ (in decimal degrees)
 Longitude: _____ (in decimal degrees)
 Elevation: _____
 Horizontal Datum: WGS84, NAD83, NAD27
 Collection Method: _____

2 WATER WELL OWNER: Flint Hills Land and Cattle
 RR#, St. Address, Box #: Green Ranch 21114 Se Summit
 City, State ZIP Code: Rd Latham Ks 67072

GPS unit (Make/Model): _____
 Digital Map/Photo, Topographic Map, Land Survey
 Est. Accuracy: <3 m, 3-5 m, 5-15 m, > 15 m

3 MARK WELL'S LOCATION WITH AN "X" IN SECTION BOX:

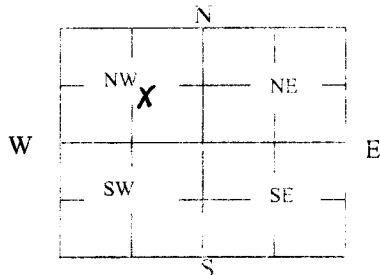

4 DEPTH OF WELL 73 ft.

WELL'S STATIC WATER LEVEL 11 ft

WELL WAS USED AS:

Domestic Public Water Supply Dewatering
 Irrigation Oil Field Water Supply Monitoring
 Feedlot Domestic (Lawn & Garden) Injection Well
 Industrial Air Conditioning Other _____

Was a chemical/bacteriological sample submitted to Department? Yes No

5 TYPE OF BLANK CASING USED:

Steel RMP (SR) Wrought Fiberglass Other (Specify below) _____
 PVC ABS Asbestos-Cement Concrete tile _____

Blank casing diameter 10 in. Was casing pulled? Yes No If yes, how much _____
 Casing height above or below land surface 3ft below in.

6 GROUT PLUG MATERIAL:

Neat cement Cement grout Bentonite Other _____

GROUT PLUG INTERVALS: From _____ ft. to _____ ft., From _____ ft. to _____ ft., From _____ ft. to _____ ft.

What is the nearest source of possible contamination:

Septic tank Seepage pit Fuel storage Other (specify below) _____
 Sewer lines Pit privy Fertilizer storage _____
 Watertight sewer lines Sewage lagoon Insecticide storage _____
 Lateral lines Feedyard Abandoned water well Direction from well? _____
 Cess pool Livestock pens Oil well/Gas well How many feet? _____

FROM	TO	PLUGGING MATERIALS	FROM	TO	PLUGGING MATERIALS
73	11	Sand			
11	3	Clay			
3	0	Neat Cement			

7 CONTRACTOR'S OR LANDOWNER'S CERTIFICATION: This water well was plugged under my jurisdiction and was completed on (mo/day/year) 1/19/16 and this record is true to the best of my knowledge and belief. Kansas Water Well Contractor's License No. #913. This Water Well Record was completed on (mo/day/year) 1/25/16 under the business name of Flint Hills Windmill and Pump Service by (signature) Top Jones

Send one white copy to Kansas Department of Health & Environment, Geology Section, 1600 SW Jackson Street, Ste. 420, Topeka, KS 66612-1367. Send one copy to WATER WELL OWNER and retain one for your records.
 Visit us at <http://www.kdheks.gov/waterwell/index.html> Telephone 785-296-5724