


1 LOCATION OF WATER WELL: County: Washington Fraction: NW 1/4 NE 1/4 NE 1/4 Section Number: 8 Township Number: T 2 S Range Number: R 1 E

Distance and direction from nearest town or city street address of well if located within city?  
6 3/4 E Mahaska Ks

2 WATER WELL OWNER: Dewayne Rose RR#, St. Address, Box #: 870 29th Rd City, State, ZIP Code: Mahaska Ks 66955 Board of Agriculture, Division of Water Resources Application Number:

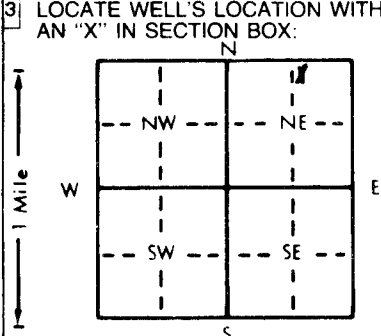

4 DEPTH OF COMPLETED WELL: 274 ft. ELEVATION: ... ft.  
 Depth(s) Groundwater Encountered 1. 142.5 ft. 2. ... ft. 3. ... ft.  
 WELL'S STATIC WATER LEVEL 142.5 ft. below land surface measured on mo/day/yr 8-23-96  
 Pump test data: Well water was 210 ft. after 1 hours pumping 10 gpm  
 Est. Yield 10+ gpm Well water was ... ft. after ... hours pumping ... gpm  
 Bore Hole Diameter 9 in. to 25 ft., and 8 1/2 in. to 274 ft.  
 WELL WATER TO BE USED AS:  
 1 Domestic     3 Feedlot     6 Oil field water supply     9 Dewatering     12 Other (Specify below)  
 2 Irrigation     4 Industrial     7 Lawn and garden only     10 Monitoring well  
 Was a chemical/bacteriological sample submitted to Department? Yes ... No X; If yes, mo/day/yr sample was submitted  
 Water Well Disinfected? Yes OX No

5 TYPE OF BLANK CASING USED:  
 1 Steel     3 RMP (SR)     6 Asbestos-Cement     9 Other (specify below)    CASING JOINTS: Glued X Clamped ...  
 2 PVC     4 ABS     7 Fiberglass    Welded ...  
 Blank casing diameter 5 in. to 214 ft., Dia ... in. to ... ft., Dia ... in. to ... ft.  
 Casing height above land surface 15 in., weight ... lbs./ft. Wall thickness or gauge No. .214  
 TYPE OF SCREEN OR PERFORATION MATERIAL:  
 1 Steel     3 Stainless steel     5 Fiberglass     8 RMP (SR)     11 Other (specify) ...  
 2 Brass     4 Galvanized steel     6 Concrete tile     9 ABS     12 None used (open hole)  
 SCREEN OR PERFORATION OPENINGS ARE:  
 1 Continuous slot     3 Mill slot     5 Gauzed wrapped     8 Saw cut     11 None (open hole)  
 2 Louvered shutter     4 Key punched     6 Wire wrapped     9 Drilled holes  
 7 Torch cut     10 Other (specify) ...  
 SCREEN-PERFORATED INTERVALS: From 214 ft. to 274 ft., From ... ft. to ... ft.  
 GRAVEL PACK INTERVALS: From 26 ft. to 45 ft., From 49 ft. to 274 ft.

6 GROUT MATERIAL: 1 Neat cement    2 Cement grout    3 Bentonite    4 Other Hole Plug  
 Grout Intervals: From 5 ft. to 26 ft., From 45 ft. to 49 ft., From ... ft. to ... ft.  
 What is the nearest source of possible contamination:  
 1 Septic tank     4 Lateral lines     7 Pit privy     10 Livestock pens     14 Abandoned water well  
 2 Sewer lines     5 Cess pool     8 Sewage lagoon     11 Fuel storage     15 Oil well/Gas well  
 3 Watertight sewer lines     6 Seepage pit     9 Feedyard     12 Fertilizer storage     16 Other (specify below)  
 13 Insecticide storage  
 Direction from well? SE How many feet? 50+

FROM	TO	LITHOLOGIC LOG	FROM	TO	PLUGGING INTERVALS
0	15	Top soil & clay's			
15	40	Chalk rock (hard)			
40	135	Shale			
135	210	Shale w/ some imbedded rocks			
210	273	Shale w/ lot of imbedded rocks			
273	278	Shale Reddish color			

7 CONTRACTOR'S OR LANDOWNER'S CERTIFICATION: This water well was  (1) constructed,  (2) reconstructed, or  (3) plugged under my jurisdiction and was completed on (mo/day/year) 8-3-96 and this record is true to the best of my knowledge and belief. Kansas Water Well Contractor's License No. 165 This Water Well Record was completed on (mo/day/yr) 8-26-96 10:PM under the business name of MARuhn Well Drilling by (signature) Teroy Maruhn

INSTRUCTIONS: Use typewriter or ball point pen. PLEASE PRESS FIRMLY and PRINT clearly. Please fill in blanks, underline or circle the correct answers. Send top three copies to Kansas Department of Health and Environment, Bureau of Water, Topeka, Kansas 66620-0001. Telephone: 913-296-5545. Send one to WATER WELL OWNER and retain one for your records.